



**Zebra Mussel Monitoring Report  
 Method A – Presence / Absence**

**Notice:** Information on this voluntary form is collected under ss. 33.02 and 281.11, Wis. Stats. Personally identifiable information, including such data as volunteer name, address, phone number, will be used for management of DNR programs. Wisconsin's Open Records laws, s. 19.32-19.39, Wis. Stats., require the Department to provide this information upon request.

**Instructions:** Fill out form and mail to the WI DNR Zebra Mussel contact person for your area.

**Collector Data**

Last Name <i>Robaidek</i>	First <i>Charmaine</i>	MI <i>K</i>	Are you a Volunteer? <input type="checkbox"/> Yes <input checked="" type="checkbox"/> No
------------------------------	---------------------------	----------------	---

Address  
*WDNR 2984 Shawano Ave, Box 10448*

City <i>Green Bay</i>	State <i>WI</i>	ZIP Code <i>54307-0448</i>
--------------------------	--------------------	-------------------------------

Telephone Number <i>920-662-5423</i>	Email Address (optional) <i>robaidek.charmaine@dnr.state.wi.us</i>
---	---

**Monitoring Location**

Date <i>8-30-05</i>	Time	County <i>Oconto</i>
------------------------	------	-------------------------

Lake Address, further explanation town/range/section and latitude and longitude optional  
*T 28 R 19 E 26*

Body of Water <i>Oconto Falls Pond</i>	Waterbody ID Number (if known) <i>449300</i>
---	---

Nearest Landmark (boat ramp, bridge, pier, etc.)  
*1. City Park (north side) & swim beach ~~at swim beach~~ to 25' upstream <sup>along Hwy 22</sup>*  
*2. Directly South of beach along south shore of flange*

Distance and Direction from Landmark

Water Body Type: <input type="checkbox"/> River / Stream <input type="checkbox"/> Canal / Ditch <input type="checkbox"/> Natural Lake / Pond <input checked="" type="checkbox"/> Man-made Reservoir <input type="checkbox"/> Marsh / Swamp <input type="checkbox"/> Estuary / Bay	Water Depth where ZM Found <i>2 feet of water and less</i>
---	---

Describe exactly how the zebra mussels were found (what they were attached to or other comments)

*Zebra mussel adults were found by wading the shore-lines & hand picking rocks looking for adults. This was done along short sections on the north & south shores ~~of~~ of the flange. Sacks also found several small adults on the dock <sup>legs</sup> enclosing the swim beach on the north shore ~~underwater~~ off Hwy 22.*

**Monitoring Results**

Total Number of Zebra Mussels Found: <i>many found, 11 collected</i>	<p><b>Note:</b> If more than 20 zebra mussels are found, measure 20 mussels chosen randomly from the sample. If less than 20 mussels are found, measure all mussels. Report results in the table on page 2 of this form.</p>
Size of Largest Zebra Mussel Found: <i>27 mm</i>	
Size of Smallest Zebra Mussel Found: <i>5 mm</i>	

Zebra Mussel Monitoring Report  
Method A – Presence / Absence

Form 3200-122A (3/05)

Page 2 of 2

Length of Zebra Mussels from Sample

If more than 20 zebra mussels are found, measure 20 mussels chosen randomly from the sample. If less than 20 mussels are found, measure all mussels.


Number	Length (mm)
1	27
2	22
3	11
4	10
5	9
6	8
7	7
8	7
9	5
10	5
11	5
12	+ several adults
13	less than 5mm
14	were attached to
15	the larger mussels
16	listed above.
17	
18	
19	
20	

**Note:** All initial discoveries should be placed in rubbing alcohol until verification by an expert is obtained.

STATE OF MISSISSIPPI  
DEPARTMENT OF NATURAL RESOURCES

LAKE SURVEY MAP

SECTION 24, T. 20 N., R. 12 E.  
L. 20 N., R. 12 E.  
AFC 22, 21, 20, 19, 18, 17, 16, 15, 14, 13, 12, 11, 10, 9, 8, 7, 6, 5, 4, 3, 2, 1

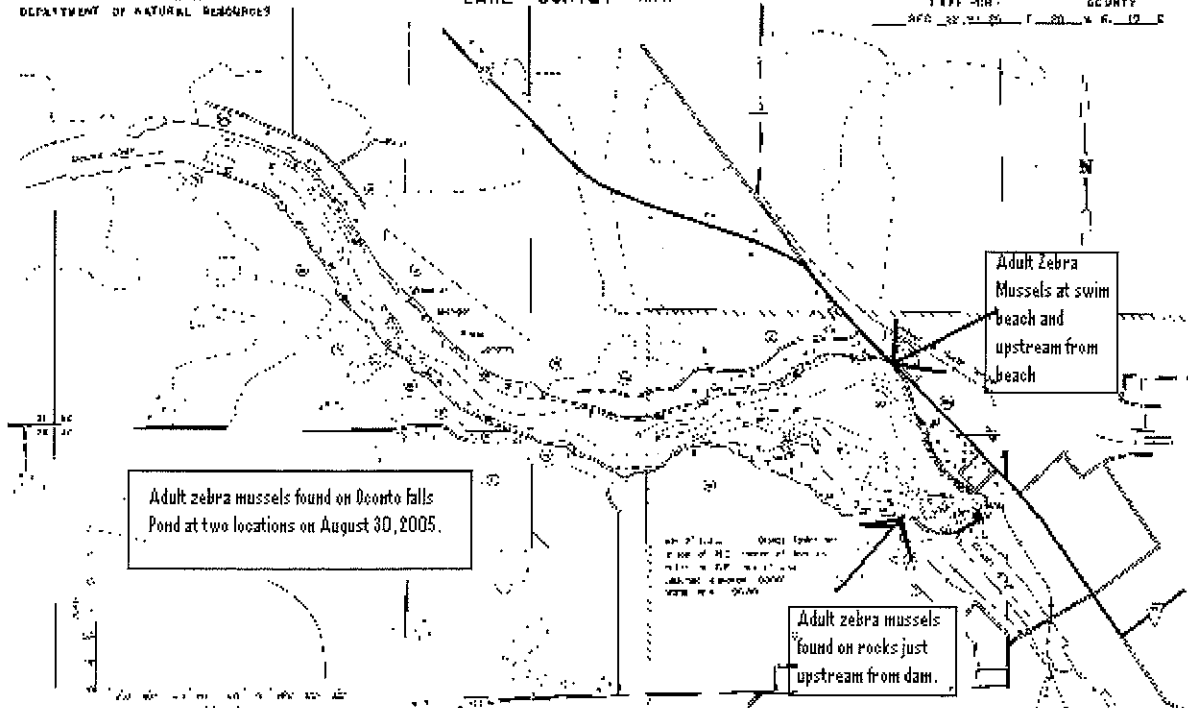

EQUIPMENT	STATION	DEPTH	SPREAD	MARKER	DATE	TIME
1	100	10	10	10	10	10
2	200	20	20	20	20	20
3	300	30	30	30	30	30
4	400	40	40	40	40	40
5	500	50	50	50	50	50
6	600	60	60	60	60	60
7	700	70	70	70	70	70
8	800	80	80	80	80	80
9	900	90	90	90	90	90
10	1000	100	100	100	100	100

Scale: 1" = 100'

North Arrow

DATE	TIME	DEPTH	SPREAD	MARKER
10/10/05	10:00	10	10	10
10/10/05	11:00	20	20	20
10/10/05	12:00	30	30	30
10/10/05	13:00	40	40	40
10/10/05	14:00	50	50	50
10/10/05	15:00	60	60	60
10/10/05	16:00	70	70	70
10/10/05	17:00	80	80	80
10/10/05	18:00	90	90	90
10/10/05	19:00	100	100	100