

**SKYVIEW DESIGN ELEVATIONS**



-	TOP OF BERM	605.30
-	TOP OF SAFETY SHELF	599.00
-	BOTTOM OF SAFETY SHELF	598.20
-	BOTTOM OF POND	594.00

±0.00 - FIELD ELEVATION AND LOCATION (9--7-12)

--- POND LAYOUT AS DESIGNED

--- POND LAYOUT AS CONSTRUCTED

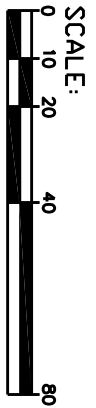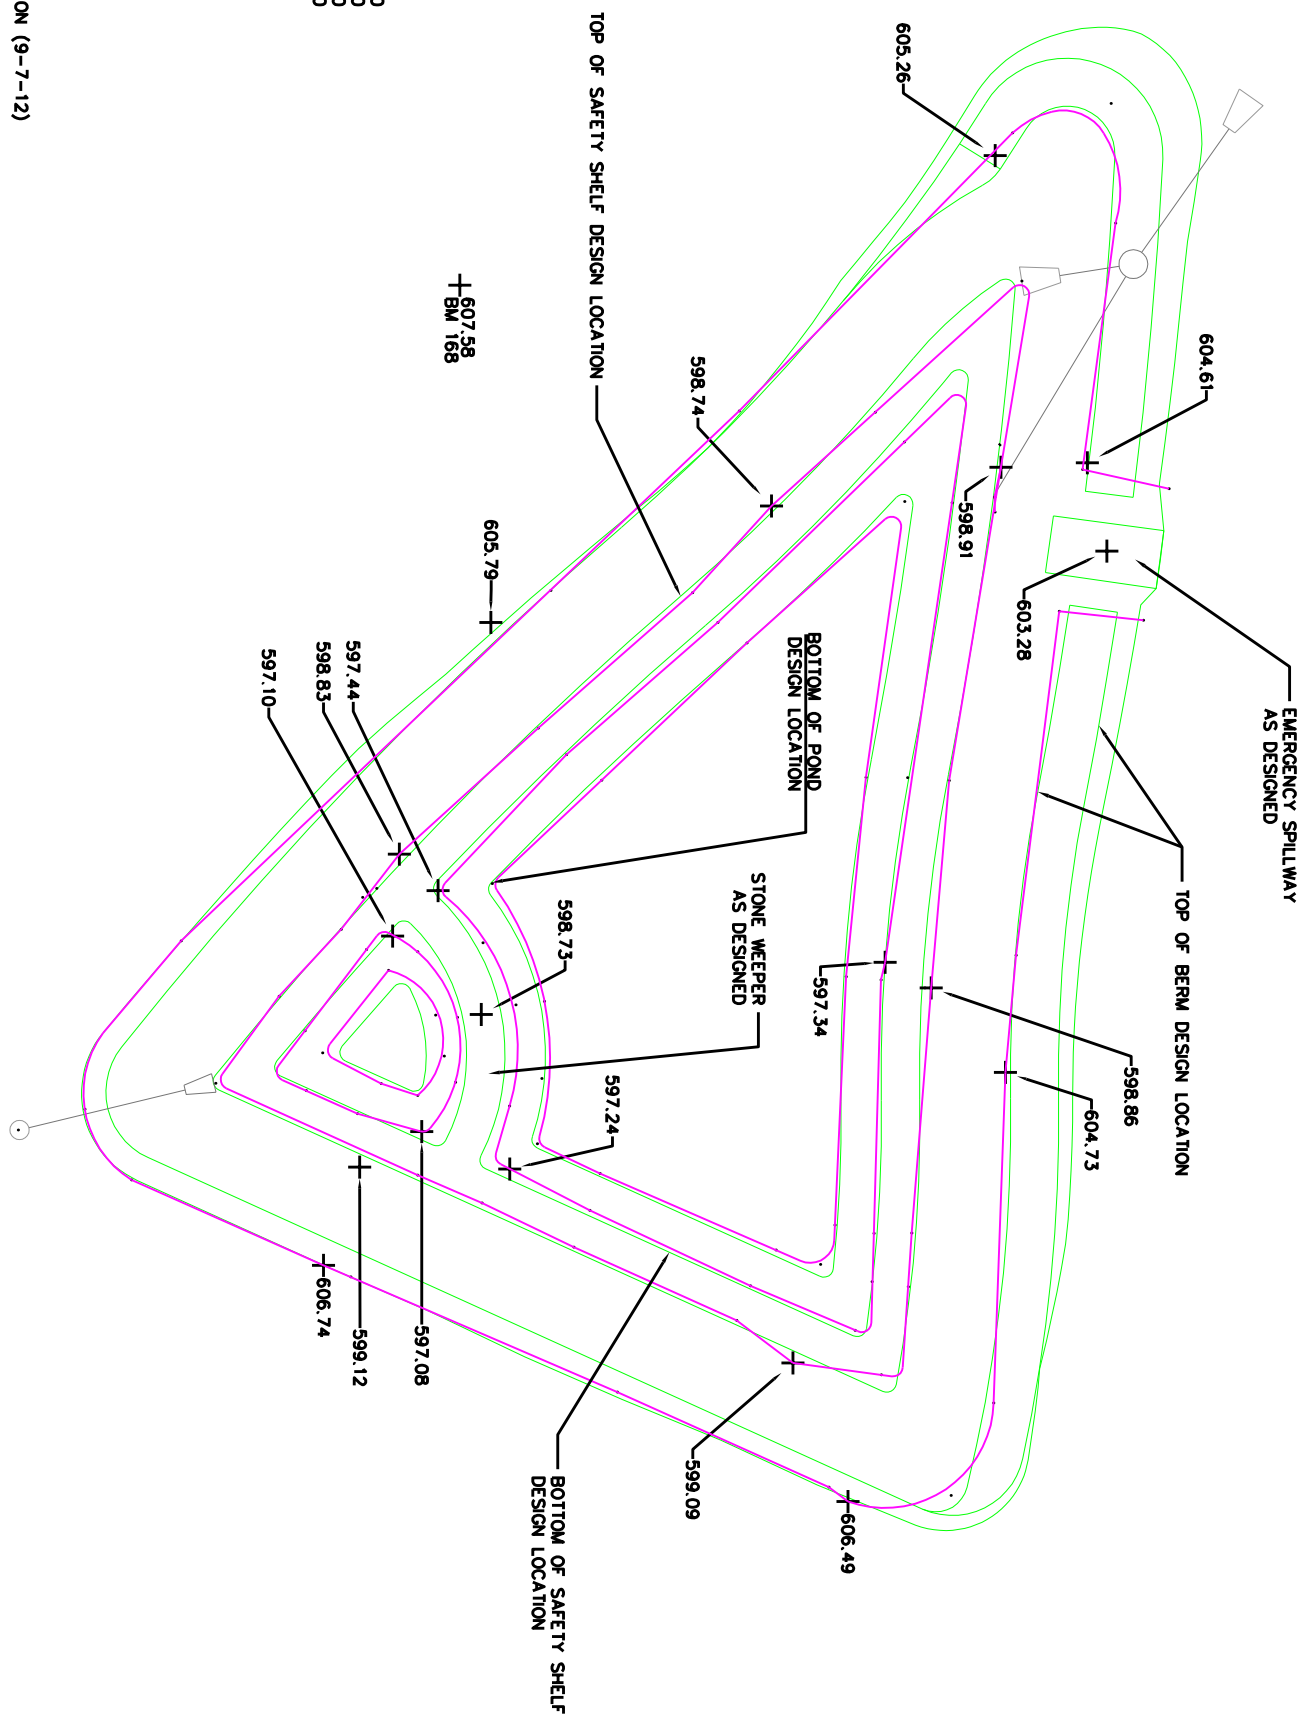

JOB NO.	10B020
BOOK NO.	
DRAWN BY	DJY
CHECKED BY	TMM
DATE	10-16-12
REVISIONS	
REFERENCE FILE	
DRAWING FILE	

**Cedar** corporation

engineers • architects • planners • environmental specialists  
land surveyors • landscape architects • interior designers

604 Wilson Ave. Menomonie, WI 54751 715-235-9081 FAX 715-235-2727	1402 Pankratz St. Suite 320 Madison, WI 53704 608-249-5046 FAX 608-249-5824	2737 S. Ridge Rd. Suite 400 Green Bay, WI 54304 920-491-9081 FAX 920-491-9020
--	---	---

800-472-7372  
www.cedarcorp.com

**SKYVIEW POND**  
 RECORD MEASURES vs AS BID  
 STORM WATER MANAGEMENT  
 VILLAGE OF BELLEVUE

SHEET NO.  
 1 OF 1