

From: Gielniewski, Margaret <gielniewski.margaret@epa.gov>
Sent: Tuesday, May 10, 2022 3:10 PM
To: Dombrowski, Frank J
Cc: Krueger, Sarah E - DNR; Korpela, Adrienne/MKE; Gielniewski, Margaret; Marcus Byker (Marcus.Byker@ramboll.com)
Subject: FW: Marinette - USEPA Meeting Minutes_4/7/22
Attachments: Conceptual Revised Alternatives Array Table_JSS.pdf; Conceptual Alternative Figures JSS.pdf

**CAUTION: This email originated from outside the organization.
Do not click links or open attachments unless you recognize the sender and know the content is safe.**

Hello Frank,

EPA, DNR and Jacobs reviewed WEC Energy's updated alternatives and have attached our comments informally as PDF markups. Included are specific suggestions for modifications to the updated alternatives that we would like to discuss (you're on the right track and we would like to discuss technical details).

We also wanted to provide input regarding the Treatability Testing and Principal Threat Waste (PTW) discussion. Based on discussions with Jacobs' Subject Matter Expert, it would be best if WEC Energy could first have the vendor perform a "proof-of-concept" bench-scale test using NAPL collected from the site. The purpose of this chemical reactivity testing would be to ensure that the reagent would adequately react with the NAPL and to determine what the end reaction material would be. It would be a quick "beaker test" where they would mix some NAPL samples with a few different dosages of reagent. It would be important to see if the reaction end products are stable or not (if reaction even occurs). Assuming that the test results are positive and demonstrate proof-of-concept, then they could proceed with a full-scale treatability study in parallel with the Feasibility Study, which they would use to refine the results, optimize conceptual design, and determine dosages, etc. The results of this testing could be included with Revision 1 of the FS.

Regarding the subject of whether or not the NAPL would remain a principal threat waste (PTW) after treating it with ISGS, the answer is "it depends." The answer to this question would largely depend on what the end products of the reaction are. The proof-of-concept testing could help answer this question as well. If the NAPL, when it reacts with the ISGS reagent(s), forms a very stable and immobile material, then you could say it is adequately treated and is no longer a PTW. However, if it is unstable, then this may not be the case – it may still be considered a PTW if it is still mobile or has the potential to easily revert back into a mobile state.

Let me know if you have any questions or would like to discuss further. I look forward to the planned discussion coming up, and we are willing to meet more than once to discuss further.

Kind regards,
Margaret

From: Dombrowski, Frank J <frank.dombrowski@wecenergygroup.com>
Sent: Monday, April 11, 2022 2:01 PM
To: Gielniewski, Margaret <gielniewski.margaret@epa.gov>
Cc: 'sarah.krueger@wisconsin.gov' <sarah.krueger@wisconsin.gov>; Marcus Byker (Marcus.Byker@ramboll.com) <Marcus.Byker@ramboll.com>; Abigail Small (ASMALL@ramboll.com) <ASMALL@ramboll.com>; Korpela, Adrienne/MKE <Adrienne.Korpela@jacobs.com>; Seaman, Jennifer/CHC <Jennifer.Seaman@jacobs.com>
Subject: [EXTERNAL] Marinette - USEPA Meeting Minutes_4/7/22

Hi Margaret,

Attached for your records is the slide deck, figures, tables and minutes from our teleconference of 4/7/22. Please let us know within 5 business days if you may have any questions or comments on the minutes.

Thanks,

Frank Dombrowski
Principal Environmental Consultant

WEC Energy Group - Business Services
Environmental Dept. - Land Quality Group
333 W. Everett St., A231
Milwaukee, WI 53203
Office: (414) 221-2156
Cell: (414) 587-4467
Fax: (414) 221-2022

Serving WEC Energy Group, We Energies, Wisconsin Public Service, Michigan Gas Utilities, Minnesota Energy Resources, Peoples Gas and North Shore Gas

From: Marcus D Byker <Marcus.Byker@ramboll.com>
Sent: Monday, April 11, 2022 1:49 PM
To: Dombrowski, Frank J <frank.dombrowski@wecenergygroup.com>
Subject: RE: Marinette - USEPA Meeting Minutes

***** Exercise caution: This is an EXTERNAL email. DO NOT open attachments or click links from unknown senders or in unexpected emails. *****

Frank,

See attached for the finalized pdfs.

Marcus D. Byker, PE
Managing Engineer

M 616-340-8982
marcus.byker@ramboll.com

From: Dombrowski, Frank J <frank.dombrowski@wecenergygroup.com>
Sent: Monday, April 11, 2022 2:30 PM
To: Marcus D Byker <Marcus.Byker@ramboll.com>
Subject: RE: Marinette - USEPA Meeting Minutes

No I think it was factual and objective. And yes, we covered a lot of ground and it's probably a good idea to document all of that so we don't forget the gist of the conversation and who committed to do what. In general I'd rather have more detail than less, it's easier to remove stuff than add.

Thanks,

Frank Dombrowski
Principal Environmental Consultant

WEC Energy Group - Business Services
Environmental Dept. - Land Quality Group
333 W. Everett St., A231
Milwaukee, WI 53203
Office: (414) 221-2156
Cell: (414) 587-4467
Fax: (414) 221-2022

*Serving WEC Energy Group, We Energies, Wisconsin Public Service, Michigan Gas Utilities,
Minnesota Energy Resources, Peoples Gas and North Shore Gas*

From: Marcus D Byker <Marcus.Byker@ramboll.com>
Sent: Monday, April 11, 2022 1:28 PM
To: Dombrowski, Frank J <frank.dombrowski@wecenergygroup.com>
Subject: RE: Marinette - USEPA Meeting Minutes

***** Exercise caution: This is an EXTERNAL email. DO NOT open attachments or click links from unknown senders or in unexpected emails. *****

Will do. – Just to confirm, you did not have any concerns with the level of detail in the meeting minutes? It's a bit more detailed than typical, but seemed leaned in this direction to better document our discussion.

Marcus D. Byker, PE
Managing Engineer

M 616-340-8982
marcus.byker@ramboll.com

From: Dombrowski, Frank J <frank.dombrowski@wecenergygroup.com>
Sent: Monday, April 11, 2022 2:16 PM
To: Marcus D Byker <Marcus.Byker@ramboll.com>
Subject: RE: Marinette - USEPA Meeting Minutes

Thanks Marcus, please make them all pdfs and I'll send over to the EPA et al.

Thanks,

Frank Dombrowski
Principal Environmental Consultant

WEC Energy Group - Business Services
Environmental Dept. - Land Quality Group
333 W. Everett St., A231
Milwaukee, WI 53203
Office: (414) 221-2156
Cell: (414) 587-4467
Fax: (414) 221-2022

*Serving WEC Energy Group, We Energies, Wisconsin Public Service, Michigan Gas Utilities,
Minnesota Energy Resources, Peoples Gas and North Shore Gas*

From: Marcus D Byker <Marcus.Byker@ramboll.com>
Sent: Monday, April 11, 2022 12:58 PM
To: Dombrowski, Frank J <frank.dombrowski@wecenergygroup.com>
Subject: Marinette - USEPA Meeting Minutes

***** Exercise caution: This is an EXTERNAL email. DO NOT open attachments or click links from unknown senders or in unexpected emails. *****

Frank,

Attached are the following items from our meeting with USEPA.

- Slide Deck
- Draft Meeting Minutes
- Conceptual Alternative Figures

Can you please review and provide any comments so we can push these off to USEPA.

Thanks!

Marcus D. Byker, PE

Managing Engineer


M 616-340-8982
marcus.byker@ramboll.com

Connect with us  

Ramboll
333 West Wacker Drive
Suite 2700
Chicago, IL 60606
USA

<https://ramboll.com>


NOTICE - This communication may contain confidential and privileged information that is for the sole use of the intended recipient. Any viewing, copying or distribution of, or reliance on this message by unintended recipients is strictly prohibited. If you have received this message in error, please notify us immediately by replying to the message and deleting it from your computer.

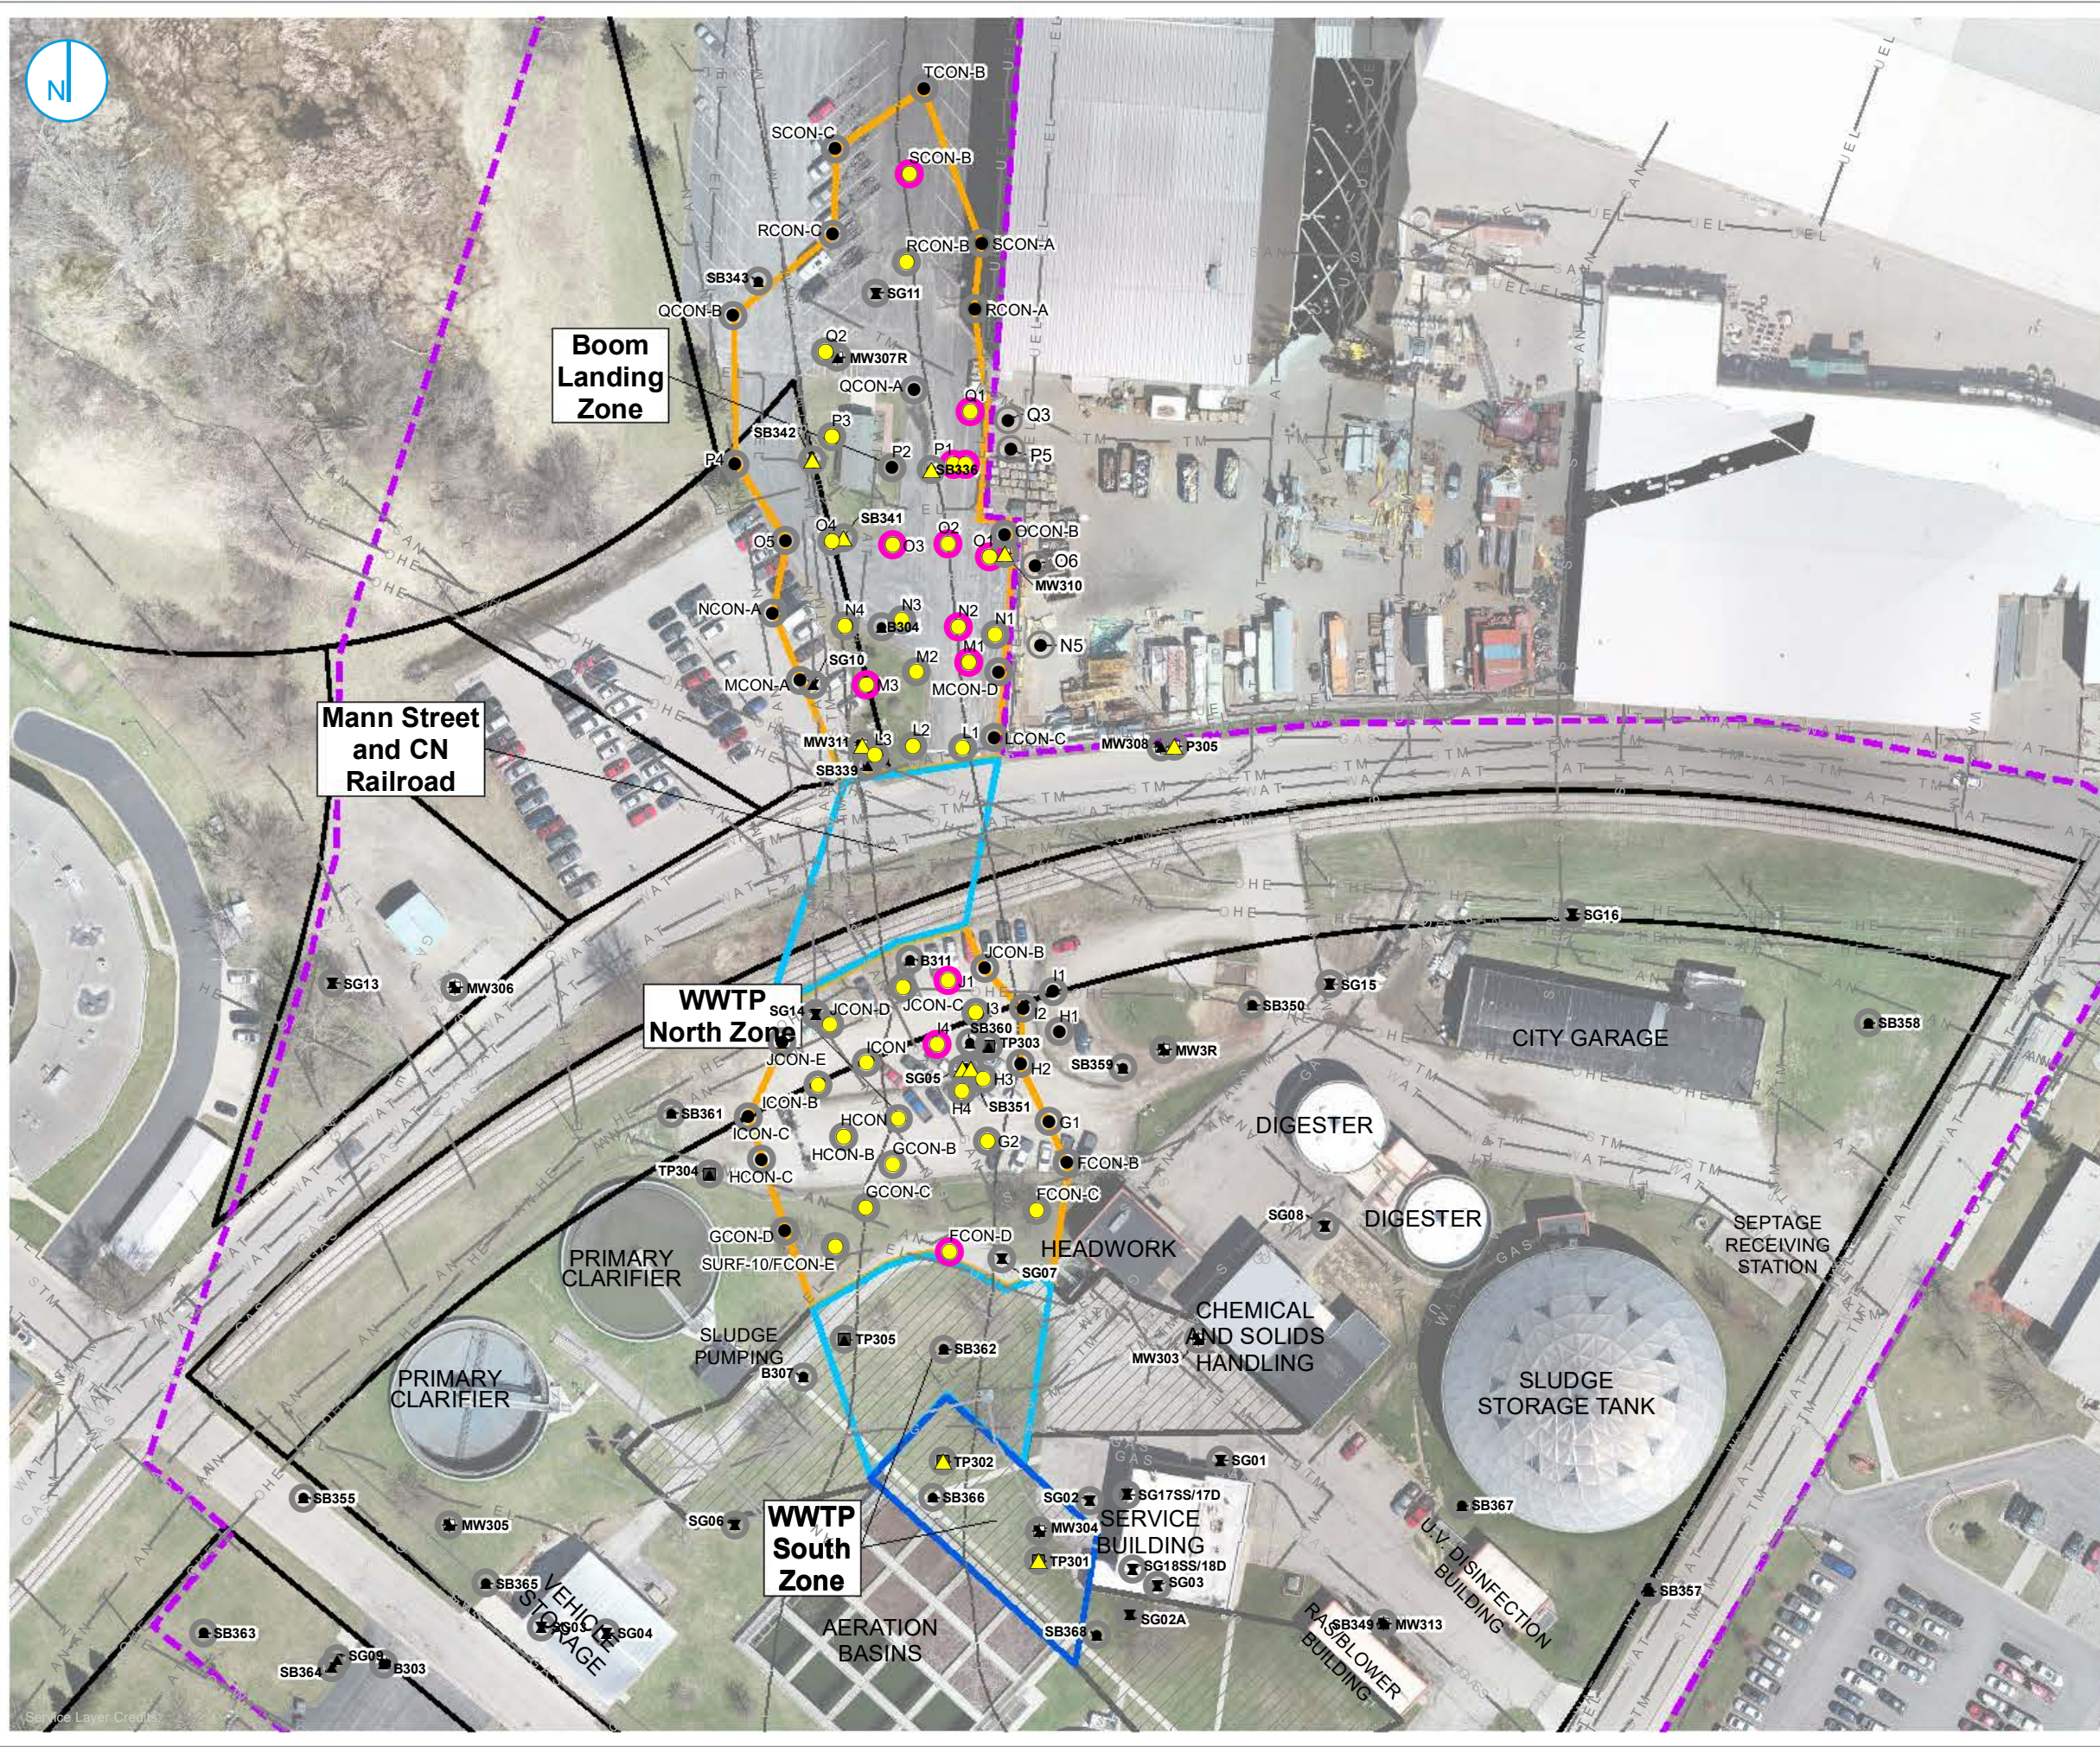

- PDI LOCATION - NO OIL - WETTED/OC
- PDI LOCATION - OIL-WETTED/OIL-COATED MATERIAL
- PDI LOCATION - NO OIL-WETTED/OIL COATED MATERIAL
- ▲ HISTORICAL LOCATION WITH OIL-WETTED/OIL-COATED MATERIAL
- ▲ HISTORICAL LOCATION WITH NO OBSERVATION OF OIL-WETTED/OIL-COATED MATERIAL
- HI>10 OR CR>1E-3
- HI<10 AND CR<1E-3

- TEL COMMUNICATIONS
- FO FIBER OPTIC
- GAS GAS
- OHE OVERHEAD ELECTRIC
- SAN SANITARY SEWER
- STM STORM SEWER
- UEL UNDERGROUND ELECTRIC
- UNDERGROUND PIPELINE
- WAT WATER
- FORMER SLOUGH/ LOG RUN
- ACCESSIBLE SOURCE MATERIAL
- AREA INACCESSIBLE TO INVESTIGATION - MAY CONTAIN SOURCE MATERIAL BASED ON POST PDI CONCEPTUAL SITE MODEL
- INACCESSIBLE SOURCE MATERIAL
- PROCESS PIPING CORRIDOR
- APPROXIMATE EXTENT OF UPLAND SITE
- PARCEL BOUNDARY

Notes:
 CR - CANCER RISK
 HI - HAZARD INDEX
 PDI - PRELIMINARY DESIGN INVESTIGATION
 WWTP - WASTEWATER TREATMENT PLAN UTILITIES FROM TERRATEC ENGINEERING LLC, WSPC MARINETTE FORMER MGP SITE PLAT OF SURVERY DATED 09/17/2020

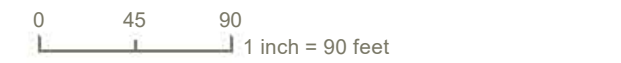


WWTP NORTH - ALT 2

PDI EVALUATION REPORT
 WSPC MARINETTE FORMER MGP SITE
 MARINETTE, WISCONSIN

FIGURE A




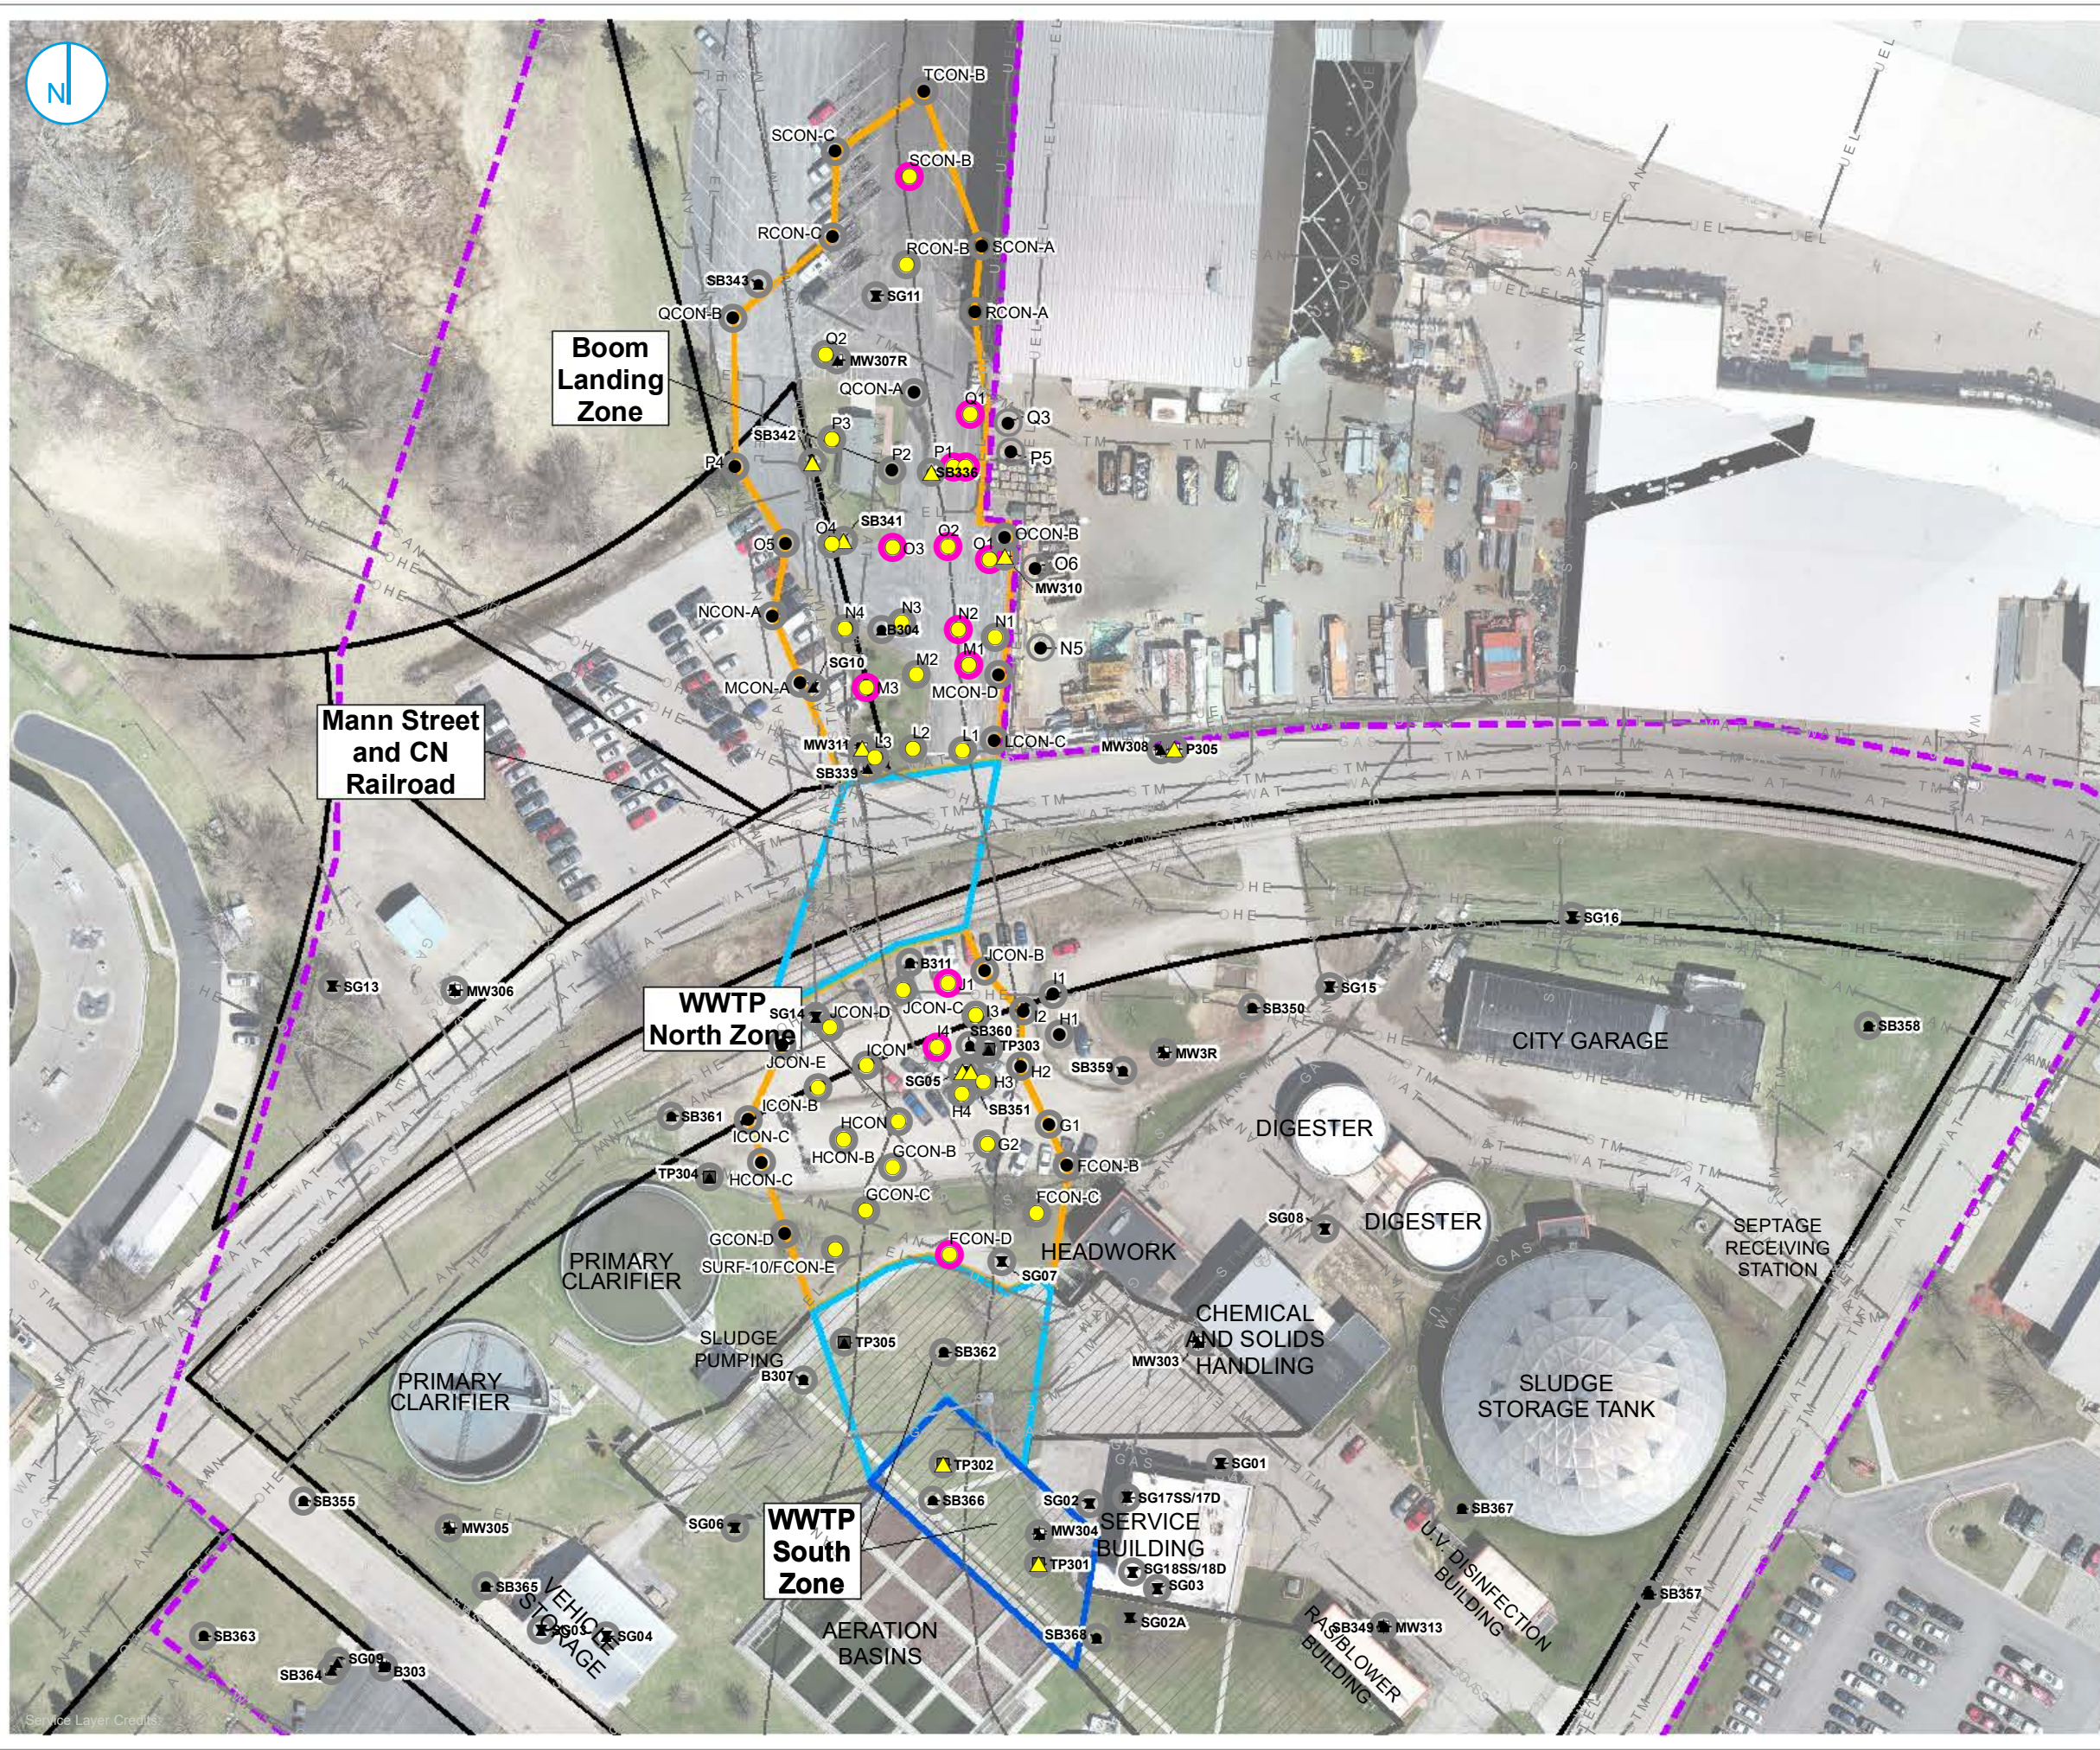

- PDI LOCATION - NO OIL - WETTED/OC
- PDI LOCATION - OIL-WETTED/OIL-COATED MATERIAL
- PDI LOCATION - NO OIL-WETTED/OIL COATED MATERIAL
- ▲ HISTORICAL LOCATION WITH OIL-WETTED/OIL-COATED MATERIAL
- ▲ HISTORICAL LOCATION WITH NO OBSERVATION OF OIL-WETTED/OIL-COATED MATERIAL
- HI>10 OR CR>1E-3
- HI<10 AND CR<1E-3

- TEL COMMUNICATIONS
- FO FIBER OPTIC
- GAS GAS
- OHE OVERHEAD ELECTRIC
- SAN SANITARY SEWER
- STM STORM SEWER
- UEL UNDERGROUND ELECTRIC
- UNDERGROUND PIPELINE
- WAT WATER
- FORMER SLOUGH/ LOG RUN
- ACCESSIBLE SOURCE MATERIAL
- AREA INACCESSIBLE TO INVESTIGATION - MAY CONTAIN SOURCE MATERIAL BASED ON POST PDI CONCEPTUAL SITE MODEL
- INACCESSIBLE SOURCE MATERIAL
- PROCESS PIPING CORRIDOR
- APPROXIMATE EXTENT OF UPLAND SITE
- PARCEL BOUNDARY

Notes:
 CR - CANCER RISK
 HI - HAZARD INDEX
 PDI - PRELIMINARY DESIGN INVESTIGATION
 WWTP - WASTEWATER TREATMENT PLAN UTILITIES FROM TERRATEC ENGINEERING LLC, WPS
 MARINETTE FORMER MGP SITE PLAT OF SURVEY DATED 09/17/2020

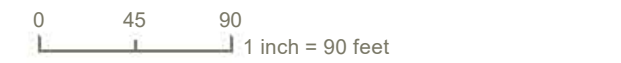


WWTP NORTH - ALT 3

PDI EVALUATION REPORT
 WPS MARINETTE FORMER MGP SITE
 MARINETTE, WISCONSIN

FIGURE B



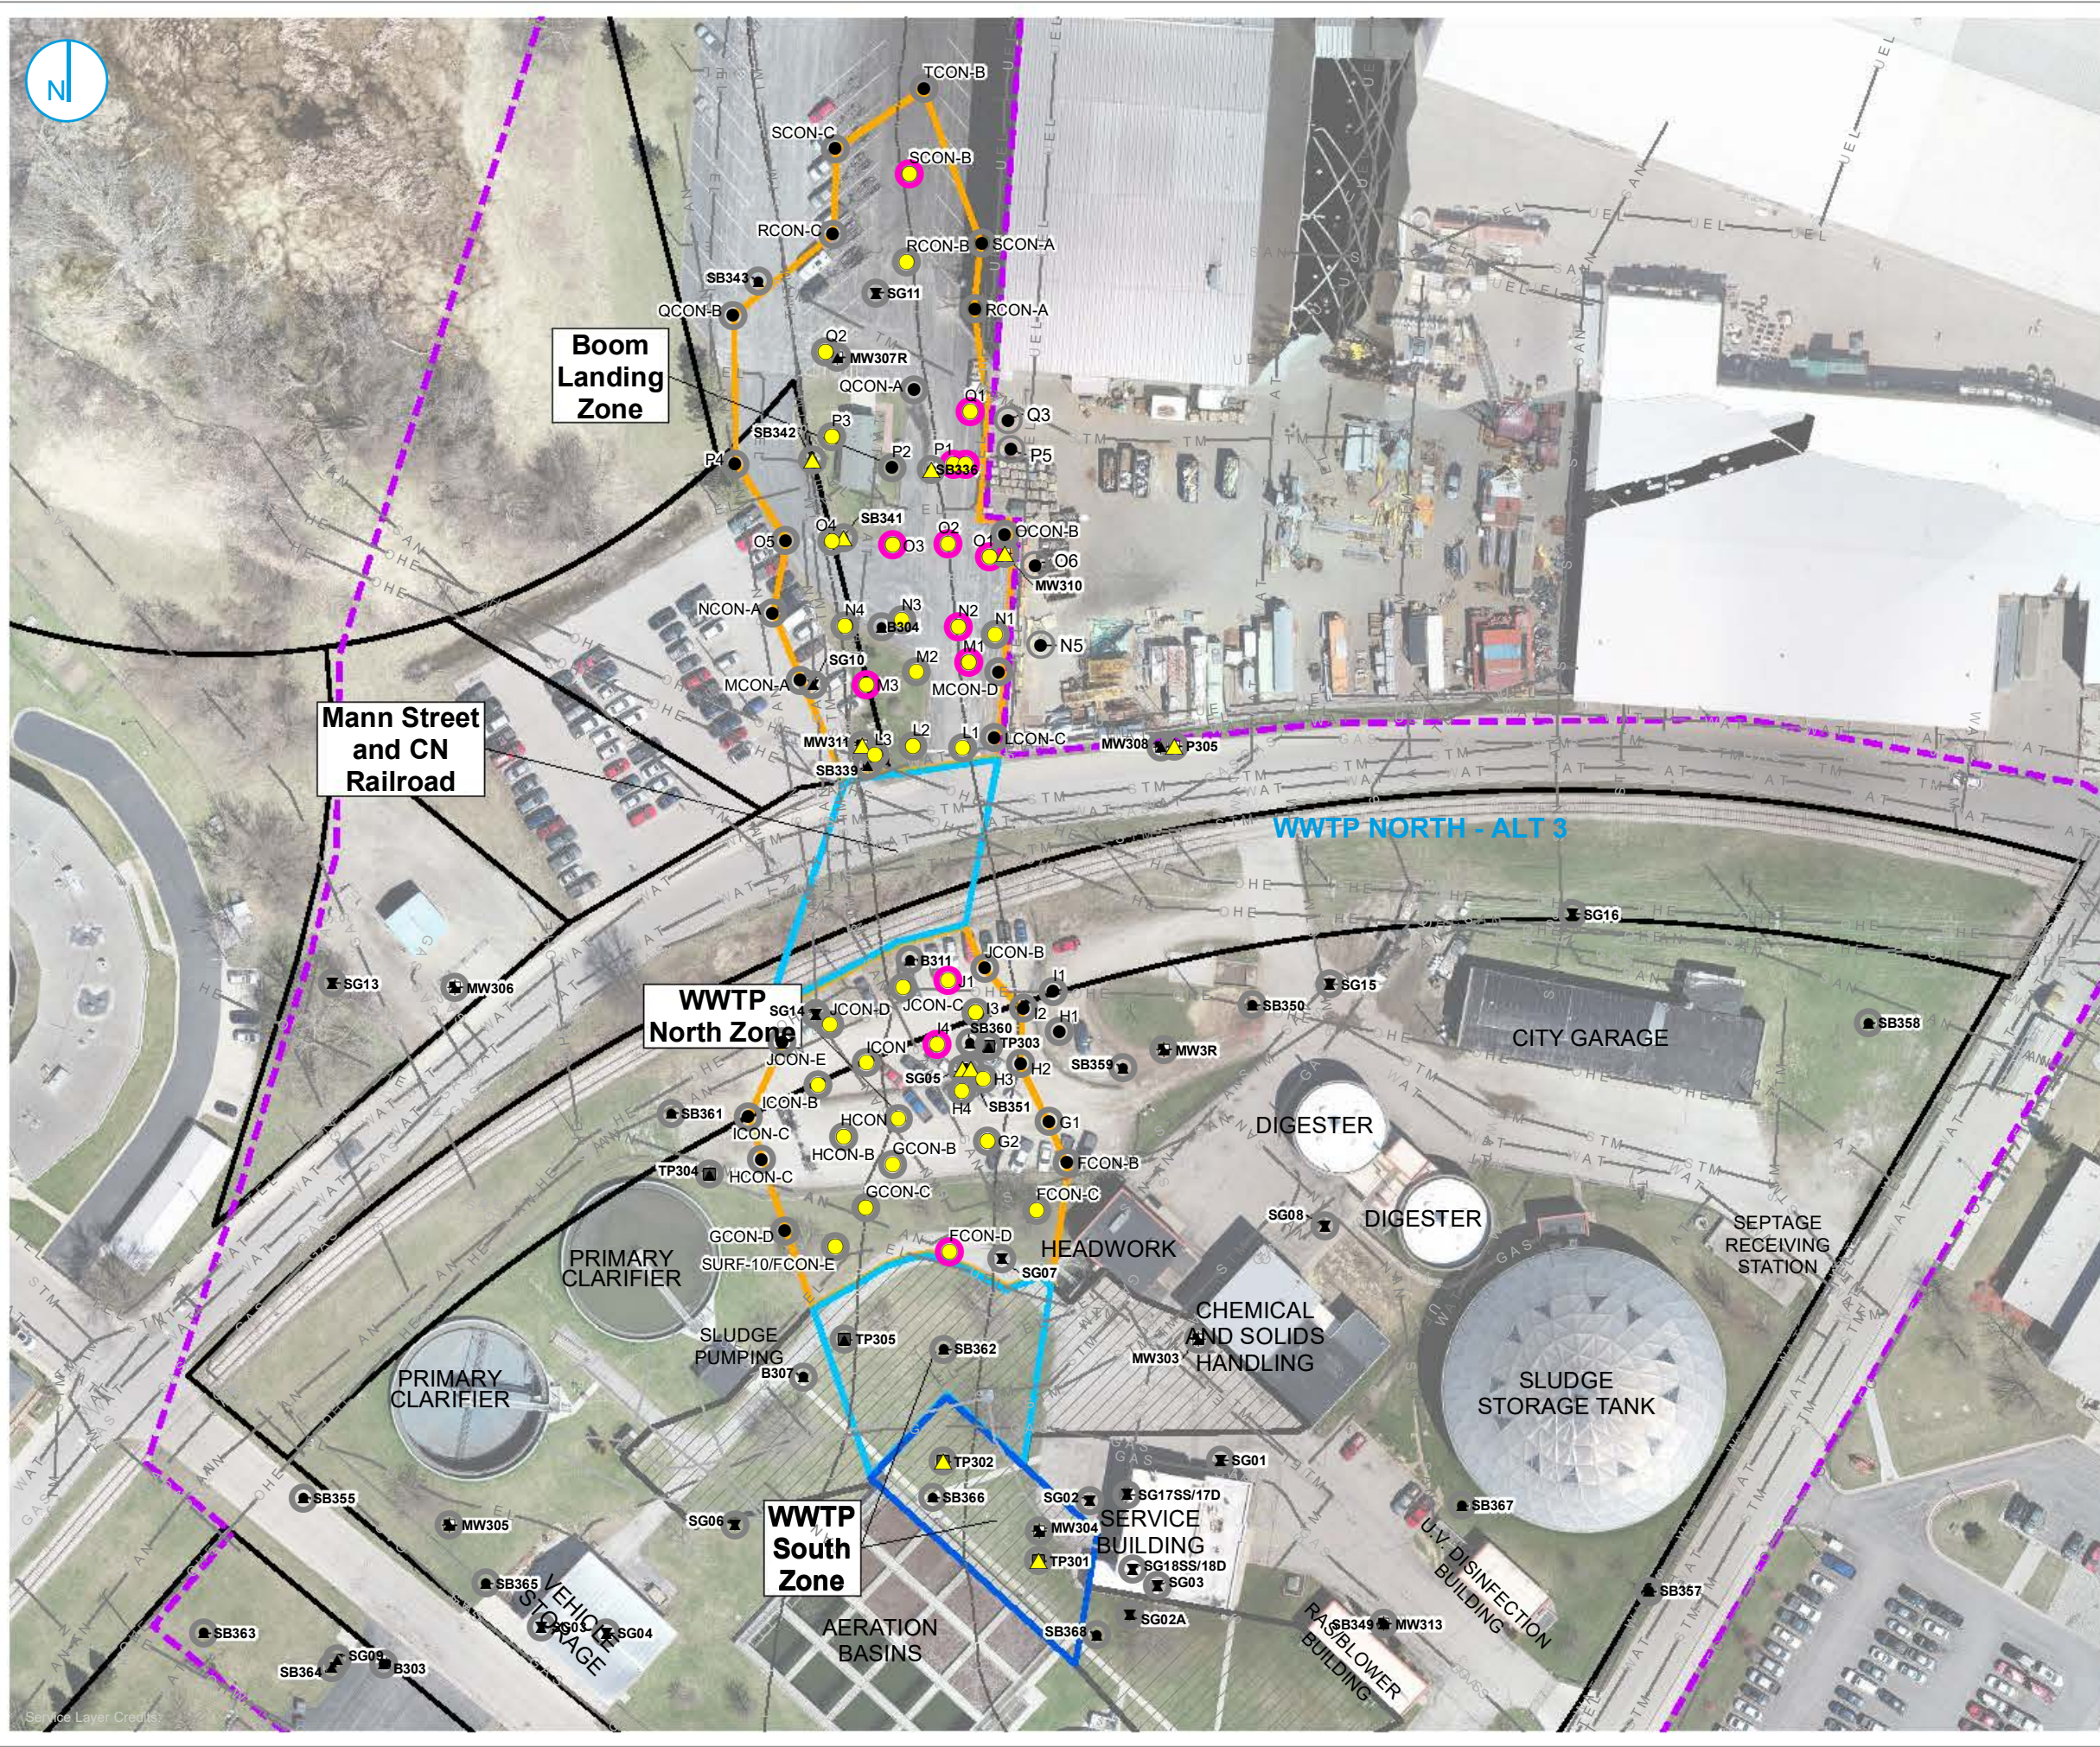

- PDI LOCATION - NO OIL - WETTED/OC
- PDI LOCATION - OIL-WETTED/OIL-COATED MATERIAL
- PDI LOCATION - NO OIL-WETTED/OIL COATED MATERIAL
- ▲ HISTORICAL LOCATION WITH OIL-WETTED/OIL-COATED MATERIAL
- ▲ HISTORICAL LOCATION WITH NO OBSERVATION OF OIL-WETTED/OIL-COATED MATERIAL
- HI>10 OR CR>1E-3
- HI<10 AND CR<1E-3

- TEL COMMUNICATIONS
- FO FIBER OPTIC
- GAS GAS
- OHE OVERHEAD ELECTRIC
- SAN SANITARY SEWER
- STM STORM SEWER
- UEL UNDERGROUND ELECTRIC
- UNDERGROUND PIPELINE
- WAT WATER
- FORMER SLOUGH/ LOG RUN
- ACCESSIBLE SOURCE MATERIAL
- AREA INACCESSIBLE TO INVESTIGATION - MAY CONTAIN SOURCE MATERIAL BASED ON POST PDI CONCEPTUAL SITE MODEL
- INACCESSIBLE SOURCE MATERIAL
- PROCESS PIPING CORRIDOR
- APPROXIMATE EXTENT OF UPLAND SITE
- PARCEL BOUNDARY

Notes:
 CR - CANCER RISK
 HI - HAZARD INDEX
 PDI - PRELIMINARY DESIGN INVESTIGATION
 WWTP - WASTEWATER TREATMENT PLAN UTILITIES FROM TERRATEC ENGINEERING LLC, WSPC MARINETTE FORMER MGP SITE PLAT OF SURVEY DATED 09/17/2020


0 45 90
 1 inch = 90 feet


PDI EVALUATION REPORT
 WSPC MARINETTE FORMER MGP SITE
 MARINETTE, WISCONSIN

FIGURE C



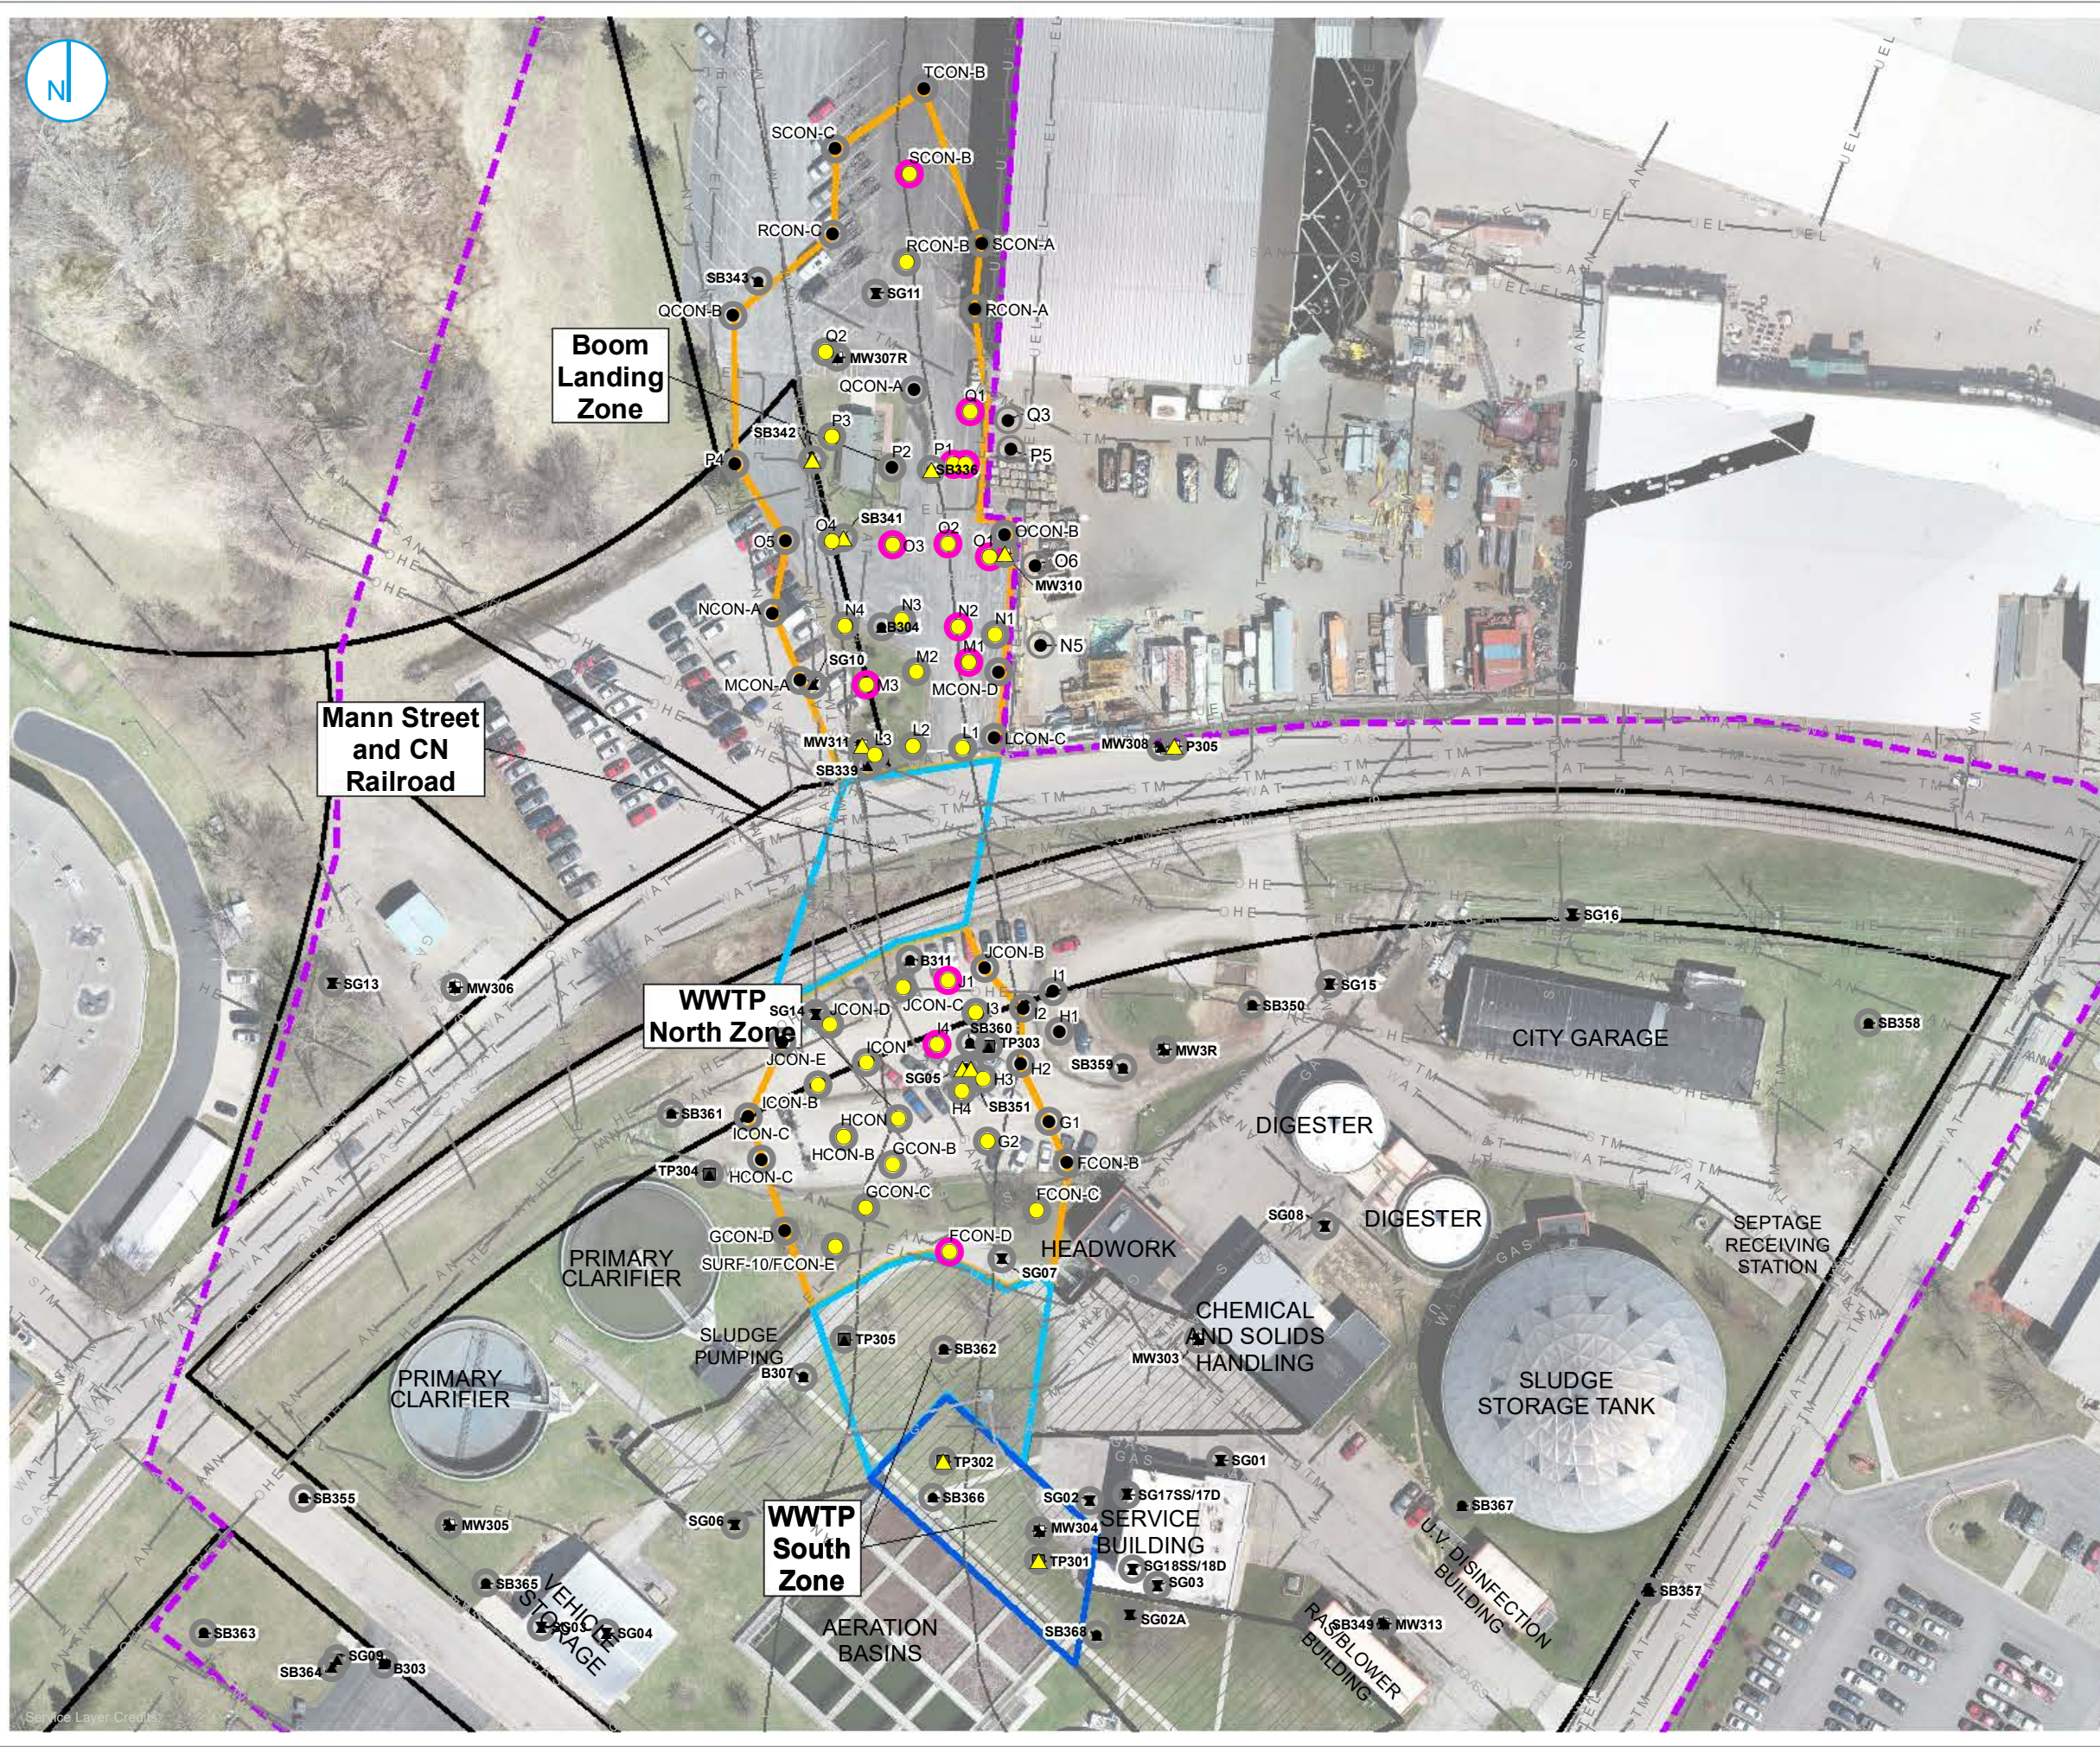


- PDI LOCATION - NO OIL - WETTED/OC
- PDI LOCATION - OIL-WETTED/OIL-COATED MATERIAL
- PDI LOCATION - NO OIL-WETTED/OIL COATED MATERIAL
- ▲ HISTORICAL LOCATION WITH OIL-WETTED/OIL-COATED MATERIAL
- ▲ HISTORICAL LOCATION WITH NO OBSERVATION OF OIL-WETTED/OIL-COATED MATERIAL
- HI>10 OR CR>1E-3
- HI<10 AND CR<1E-3

- TEL — COMMUNICATIONS
- FO — FIBER OPTIC
- GAS — GAS
- OHE — OVERHEAD ELECTRIC
- SAN — SANITARY SEWER
- STM — STORM SEWER
- UEL — UNDERGROUND ELECTRIC
- UNDERGROUND PIPELINE
- WAT — WATER
- FORMER SLOUGH/ LOG RUN

- ACCESSIBLE SOURCE MATERIAL
- AREA INACCESSIBLE TO INVESTIGATION - MAY CONTAIN SOURCE MATERIAL BASED ON POST PDI CONCEPTUAL SITE MODEL
- INACCESSIBLE SOURCE MATERIAL
- PROCESS PIPING CORRIDOR
- APPROXIMATE EXTENT OF UPLAND SITE
- PARCEL BOUNDARY

Notes:
 CR - CANCER RISK
 HI - HAZARD INDEX
 PDI - PRELIMINARY DESIGN INVESTIGATION
 WWTP - WASTEWATER TREATMENT PLAN UTILITIES FROM TERRATEC ENGINEERING LLC, WSPC MARINETTE FORMER MGP SITE PLAT OF SURVERY DATED 09/17/2020

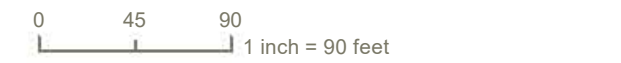


BOOM LANDING - ALT 2

PDI EVALUATION REPORT
 WSPC MARINETTE FORMER MGP SITE
 MARINETTE, WISCONSIN

FIGURE D



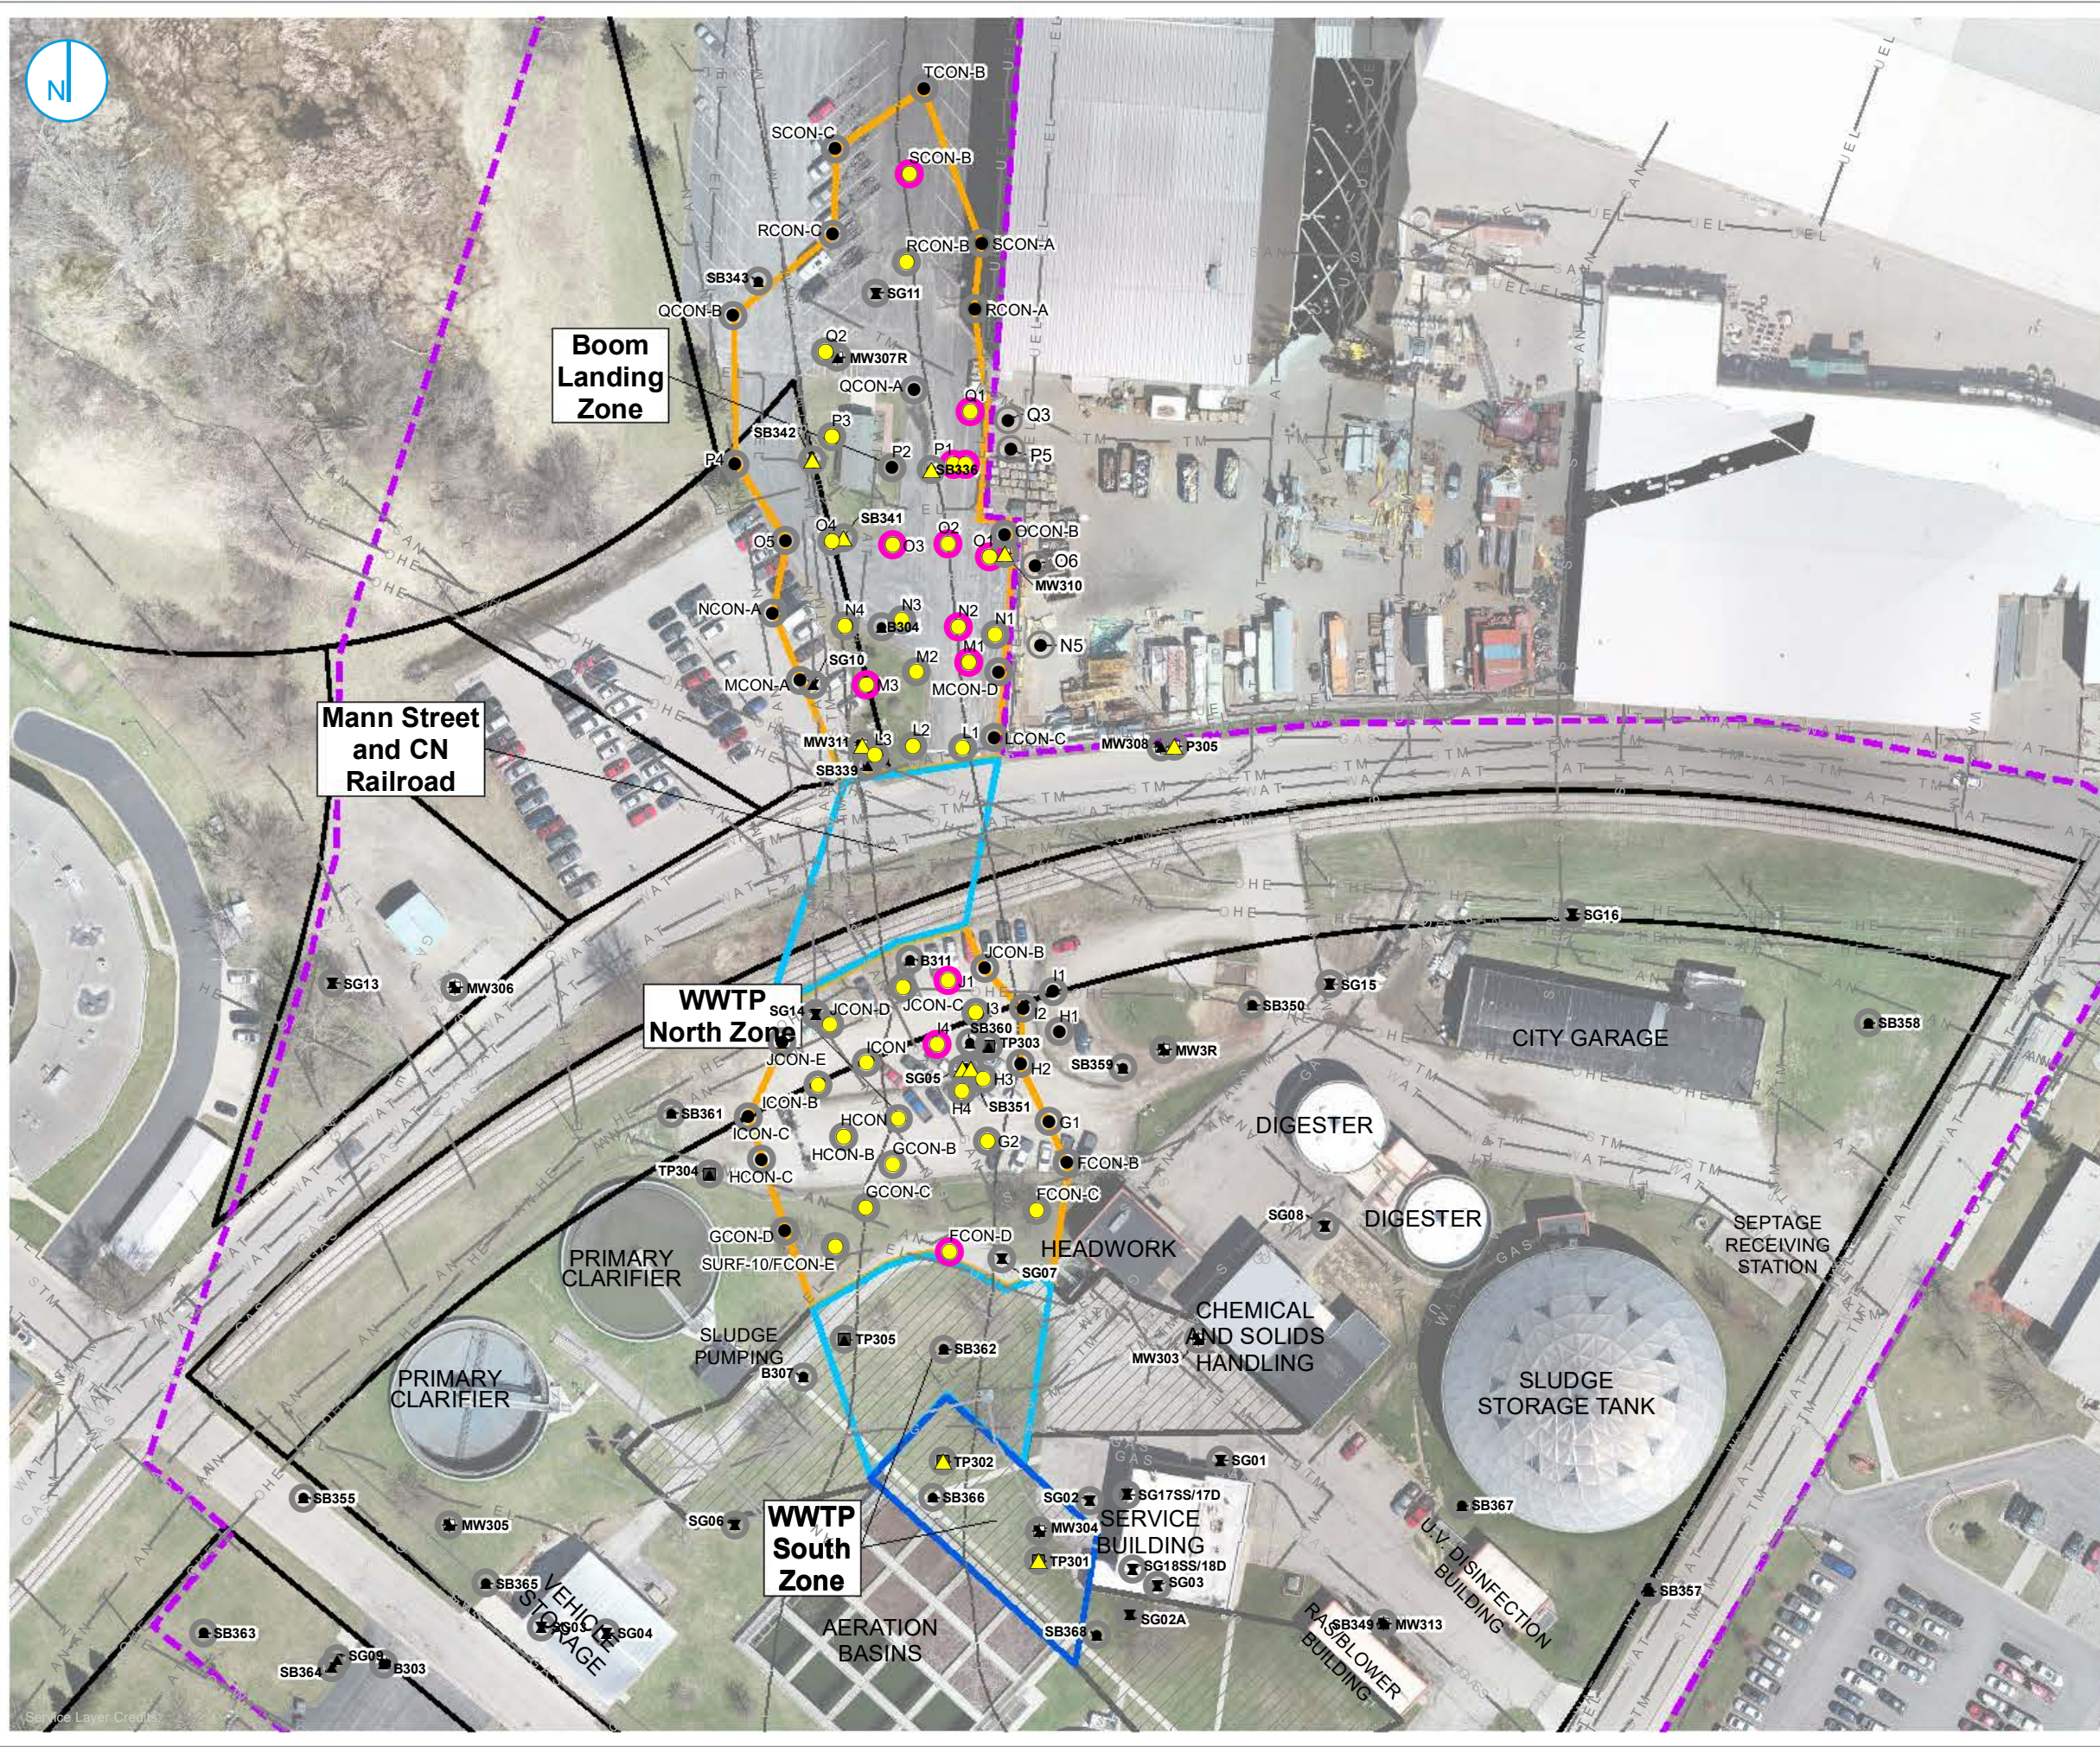

- PDI LOCATION - NO OIL - WETTED/OC
- PDI LOCATION - OIL-WETTED/OIL-COATED MATERIAL
- PDI LOCATION - NO OIL-WETTED/OIL COATED MATERIAL
- ▲ HISTORICAL LOCATION WITH OIL-WETTED/OIL-COATED MATERIAL
- ▲ HISTORICAL LOCATION WITH NO OBSERVATION OF OIL-WETTED/OIL-COATED MATERIAL
- HI>10 OR CR>1E-3
- HI<10 AND CR<1E-3
- TEL COMMUNICATIONS
- FO FIBER OPTIC
- GAS GAS
- OHE OVERHEAD ELECTRIC
- SAN SANITARY SEWER
- STM STORM SEWER
- UEL UNDERGROUND ELECTRIC
- UNDERGROUND PIPELINE
- WAT WATER
- FORMER SLOUGH/ LOG RUN
- ACCESSIBLE SOURCE MATERIAL
- AREA INACCESSIBLE TO INVESTIGATION - MAY CONTAIN SOURCE MATERIAL BASED ON POST PDI CONCEPTUAL SITE MODEL
- INACCESSIBLE SOURCE MATERIAL
- PROCESS PIPING CORRIDOR
- APPROXIMATE EXTENT OF UPLAND SITE
- PARCEL BOUNDARY

Notes:
 CR - CANCER RISK
 HI - HAZARD INDEX
 PDI - PRELIMINARY DESIGN INVESTIGATION
 WWTP - WASTEWATER TREATMENT PLAN UTILITIES FROM TERRATEC ENGINEERING LLC, WSPC MARINETTE FORMER MGP SITE PLAT OF SURVEY DATED 09/17/2020

0 45 90
 1 inch = 90 feet

BOOM LANDING - ALT 3

PDI EVALUATION REPORT
 WSPC MARINETTE FORMER MGP SITE
 MARINETTE, WISCONSIN

FIGURE E



**TABLE 4 - SUMMARY OF ASSEMBLED ALTERNATIVES
 FOCUSED ALTERNATIVES ARRAY TECHNICAL MEMORANDUM
 WISCONSIN PUBLIC SERVICE CORPORATION
 FORMER MARINETTE MANUFACTURED GAS PLANT
 BRRTS# 02-38-000047 USEPA# WIN00050995**

General Response Action	Remedial Technology	Retained Process Option	Alternative 1	Alternative 2
SOIL - Inaccessible Source Material (WWTP South Zone, CN Railroad and Mann Street Zone)				
No Action	None	No Additional Action	X	
Institutional Controls	Physical, Land Use, and/or Legislative Restrictions	Environmental Covenant and Deed Restrictions		X
Containment	Horizontal Engineered Surface Barrier	Soil, asphalt, concrete or geosynthetic covers		X

General Response Action	Remedial Technology	Retained Process Option	Alternative 1	Alternative 2	Alternative 3	Alternative 4
SOIL - Accessible Source Material - WWTP North Zone						
No Action	None	No Additional Action	X			
Institutional Controls	Physical, Land Use, and/or Legislative Restrictions	Environmental Covenant and Deed Restrictions		X	X	
In Situ Approaches	Chemical Oxidation	Geochemical Stabilization		X		
Ex Situ Approaches	Excavation	Offsite Disposal				X
In Situ Approaches	Physical/Chemical Treatment	In Situ Stabilization/Solidification			X	
Groundwater - Accessible Source Material - WWTP North Zone						
No Action	None	No Additional Action	X			
Institutional Controls	Physical, Land Use, and/or Legislative Restrictions	Environmental Covenant and Deed Restrictions		X	X	X
Physical	NAPL Recovery	Passive NAPL Recovery		X	X	X
In Situ Approaches	Barrier	Permeable Reactive Barrier (Contingent)		X	X	
In Situ Approaches	Chemical Oxidation	Amendment Addition in Excavation Backfill				X

General Response Action	Remedial Technology	Retained Process Option	Alternative 1	Alternative 2	Alternative 3
SOIL - Accessible Source Material - Boom Landing Zone					
No Action	None	No Additional Action	X		
Institutional Controls	Physical, Land Use, and/or Legislative Restrictions	Environmental Covenant and Deed Restrictions		X	
In Situ Approaches	Chemical Oxidation	Geochemical Stabilization			
Ex Situ Approaches	Excavation	Offsite Disposal			X
In Situ Approaches	Physical/Chemical Treatment	In Situ Stabilization/Solidification		X	
Groundwater - Accessible Source Material - Boom Landing Zone					

No Action	None	No Additional Action	X		
Institutional Controls	Physical, Land Use, and/or Legislative Restrictions	Environmental Covenant and Deed Restrictions		X	X
Physical	NAPL Recovery	Passive NAPL Recovery		X	X
In Situ Approaches	Barrier	Permeable Reactive Barrier (Contingent)		X	
In Situ Approaches	Chemical Oxidation	Amendment Addition in Excavation Backfill			X

Notes:

WWTP - wastewater treatment plant