Check # 3695

19-SE-005630

State of Wisconsin
Department of Natural Resources
PO Box 7921, Madison WI 53707-7921
dnr.wi.gov

Fish Farm Application For Use of Natural Body of Water

Form 3600-227 (R 3/13)

Notice: Use of this form is required by the Department for any application filed pursuant to ss. 29.733, Wis. Stats., and ss. NR 19.90-95, Wis. Adm. Code. The department will not consider your application unless you provide all information requested and submit the fee(s) indicated for the permit(s) selected. A social security number or federal employer identification number is **REQUIRED** when applying for a license listed in ss. 29.024(2g) or 29.024 (2r), Wis. Stats. The number **SHALL NOT** be disclosed to any other person except the Department of Workforce Development or the Department of Revenue to determine liability for delinquent Wisconsin taxes or child or family support. Other personally identifiable information requested on this form will be used for program administration and may be provided to requesters as required by Wisconsin's Open Records law [ss. 19.31-19.39, Wis. Stats.].

Mail this form with its attachments and required fee to WDNR -Natural Waterbody Permits FH/4, PO Box 7921 Madison, WI 53707-7921.

Applicant Information

Applicant Name: First MI Last	Co-Applicant Name: First MI Last
Bradley Family Foundation	
Address: 2145 W. Brown Deer Rd.	Address
City: Milwaukee; State: WI; ZIP Code: 53217	City; State; ZIP Code
Phone Number: (414) 446-8794	Phone Number; Social Security No./ Fed. Employer ID No.

Project Information

Business Name (if any): Lynden Sculpture Garden	Waterway Name
Address: 2145 W. Brown Deer Rd.	**Water Source (identify as gallons per minute, gpm)**
○ City ○ Town ⊗ Village of River Hills	Spring; Well: 60 gpm est.; Stream; City Water; Other; Specify Other
County: Milwaukee	Fire Number (if applicable)
Is there a discharge to a water of the state? ⊗ Yes ○ No — During periods of high water	
¼ ¼: NE ¼; ¼: NW ¼; Section: 7; Township: 8 N; Range: 22 ⊗E ○W	If Yes, Indicate: ☒ Waterway (intermittent creek bed to the Milwaukee River) ☐ Wetland; Discharge (gpm): intermittent

Project Description

A "natural body of water" is defined in Wisconsin law as any spring, stream, pond, lake or wetland that was historically present in a natural state but may have been physically altered over time. A "freeze-out pond" is defined in Wisconsin law as a natural, self-contained body of water in which freezing or anoxic conditions prevent the body of water from naturally sustaining a fish population at least twice every 5 years.

Operating a fish farm in a Natural Body of Water requires a permit under NR 19, Wis. Adm. Code. I am applying for:

☒ **NR 19 Permit Renewal** - for continued use of a natural waterbody that was previously permitted as a preexisting fish rearing facility or a freeze-out pond.

☐ **Initial NR 19 Permit** - for new use of a natural waterbody for fish farming (note, the waterbody must be a freeze-out pond).

☐ **Transfer of NR 19 Permit** - to convey an existing NR 19 permit from one party to another, as a result of change in ownership or leasehold interest of a fish farm.

Number and dimension of ponds, raceways or tanks. Describe here and attach a diagram (Attachment # 4)

Business Purpose: Activities engaged in. (select all that apply)

☐ Distributor	☐ Processor, On-Site	☐ Public Fee Fishing
☐ Hatchery	☐ Grower	☐ Raising Fish For Stocking
☐ Raising Bait For Sale	☐ Private, Personal Fishing	☐ Raising Fish to Directly Market for Human Consumption

☒ Other – Specify: Raising fathead minnows to improve water quality & aesthics

1. What type of pesticides do you currently use or plan to use?
   none

2. Is your fish farm equipped with barriers that prevent the passage of fish between it and other water of the state? ⊗ Yes ○ No

3. If you are applying for an NR 19 Permit Renewal, have you made any facility changes - expansion, additional ponds, different species reared, etc. - over the last ten years?
   ○ Yes ⊗ No If yes, describe:

Bradley Family Foundation
Applicant Last Name

Fish Farm Application For Use of Natural Body of Water

Form 3600-227 (R 3/13)

Species Information

Complete the following information regarding your operation: List the quantity of each size of the species of fish you possess or plan to raise on an annual basis in each pond, raceway, natural body of water, freeze-out pond, self-contained body of water or preexisting fish rearing facility.

Fish	Eggs	Fry	Fingerling	Yearling	Adult	Fish	Eggs	Fry	Fingerling	Yearling	Adult
Bass Largemouth						Bluegill					
Bass Smallmouth						Crappie					
Bullhead						Perch					
Muskellunge						Pumpkinseed					
Northern Pike						Sunfish					
Walleye						Tilapia					
Chubs						Brook Trout					
Minnows					X	Brown Trout					
Shiners						Lake Trout					
Suckers						Rainbow Trout					
Atlantic Salmon						Other (List):					
Chinook Salmon											
Coho Salmon											

Attachments (Provide all of the following)

1. Location sketch or map showing route to the project site, indicating nearest main road and crossroad, north arrow and scale.
2. Photocopy of deed, lease, land contract or other documentation showing that the land that is riparian to the body of water is owned, leased, or controlled by the permit applicant.
3. Photocopy of plat book showing property owners; photocopy of any easements for all properties surrounding the waterbody; and other documentation to show that none of the owners of the fish farm or riparian lands provide public access to the body of water by means of an easement or right-of-way or by means of a business open to the public. Note: the owners of the fish farm may allow fishing by the public for a fee.
4. Diagram showing number and dimensions of all ponds, raceways, tanks or other waterbodies to be used for fish farming.
5. For an Initial NR 19 Permit – Documentation to show the natural waterbody is a "freeze-out pond", meaning it is self-contained and has freezing or anoxic conditions that prevent a naturally-sustaining fish population at least twice every five years.
6. For a Transfer of NR 19 Permit – Photocopy of the previous owner's NR 19 permit, and documentation to show change of ownership.
7. Photocopy of any other permits or authorizations required by Ch. 30 or 31, Wis. Stats., the Army Corps of Engineers and any other federal, state or local laws and zoning ordinances for construction or operation of the fish farm. (Note: Permits issued under Ch. 30.19, 30.195 or 31.04 may mean your waterbody is exempt from a permit requirement.)
8. Photocopy of Department of Agriculture, Trade and Consumer Protection (DATCP) Fish Farm Registration from current or previous year.

Note: If conditions 2, 3, and 7 are met, then the DNR may find that your fish farm is exempt from a Natural Waterbody permit requirement. If so, the DNR will return your application and notify you of this finding.

Type of Permit and Fees

☐ Transfer of NR 19 Permit - $100 fee	
☐ Initial NR 19 Permit - $ 500 fee	
☒ NR 19 Permit Renewal- $50 fee.	$50
Make check or money order payable to the Department of Natural Resources (DNR) **Total Fees Enclosed:**	$50

Application Certification

Signature of Authorized Representative: Robert A. Kotho (Agent)

Date Signed: 5/6/13

Leave Blank – DNR Use Only

Received By	Date Received	DNR Docket Number	Application Date

Milwaukee County Web Portal

Welcome to the **Milwaukee County, Wisconsin** Land Records Web Portal.

For Bankruptcy payoff. Please call our office 414-278-4033 for accurate amount due. Enter your search criteria and click Search to view a list of results.

Search By: **Parcel** | Reset Search | Show Search

Parcel
Taxes
Assessments
Documents
Permits
View GIS Map

View Purchased Documents
View Cart (0)

Tax Year	Prop Type	Parcel Number	Property Address	Owner
2011	Real Estate	0509999002	2145 W BROWN DEER RD	BRADLEY FAMILY

Summary

Bill #: 0

Bill Address

BRADLEY FAMILY
FOUNDATION INC
2145 W BROWN DEER RD
RIVER HILLS WI 53217-2017

Details

Description	Amount	Paid	Due
Gross Tax	0.00	-	-
School Credit	0.00	-	-
First Dollar Credit	0.00	-	-
Net Tax	0.00	0.00	0.00
Special Assessments	0.00	0.00	0.00
Special Charges	0.00	0.00	0.00
Delinquent Utility	0.00	0.00	0.00
PrivateForest Crop	0.00	0.00	0.00
Woodland Tax Law	0.00	0.00	0.00
Managed Forest Land	0.00	0.00	0.00
Other Charges	0.00	0.00	0.00
Interest	-	0.00	0.00
Penalty	-	0.00	0.00
TOTAL	0.00	0.00	0.00

Installments

Installments have not been calculated yet.

Lottery Credits

Claims	Amount
0	0.00

Payments

No payments were found

Key: Propety Type: RE - Real Estate, PP - Personal Property
Payment Type: A - Adjustment, L - Lottery, R - Redemption, T - Current Tax

Print Tax Details **Adobe Reader is required to view tax details and tax bills. Download Adobe Reader**

500 Results Found | Displaying Results 46 - 60 | Page: 1 2 3 4 5 6 7 8 9 10 ...

Type	Owner ▲	Status	Parcel #	Property Address	Municipality	PLS/Tract	Alt. Parcel #
RE	WALLNER III, ERNEST F	CURRENT OWNER	0510021	1414 W HEATHER LN	VILLAGE OF RIVER HILLS		

STATE OF WISCONSIN
DEPARTMENT OF NATURAL RESOURCES
Division of Conservation
Madison, Wisconsin 53701

Fi-262

FIELD SHEET

COUNTY Milwaukee TOWN ..... T. 8N R. 22 EW

MAPPED BY H. Horstmann DATE July 6, 19 71

TOPOGRAPHY Level SECTION Seven

SOILS Organic OWNER Margaret B. Bradley

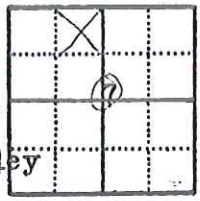

—OTHER DATA—

1/10 inch = 66 feet
(7) center of Section
☒ area to be licensed
NE ¼ NW ¼

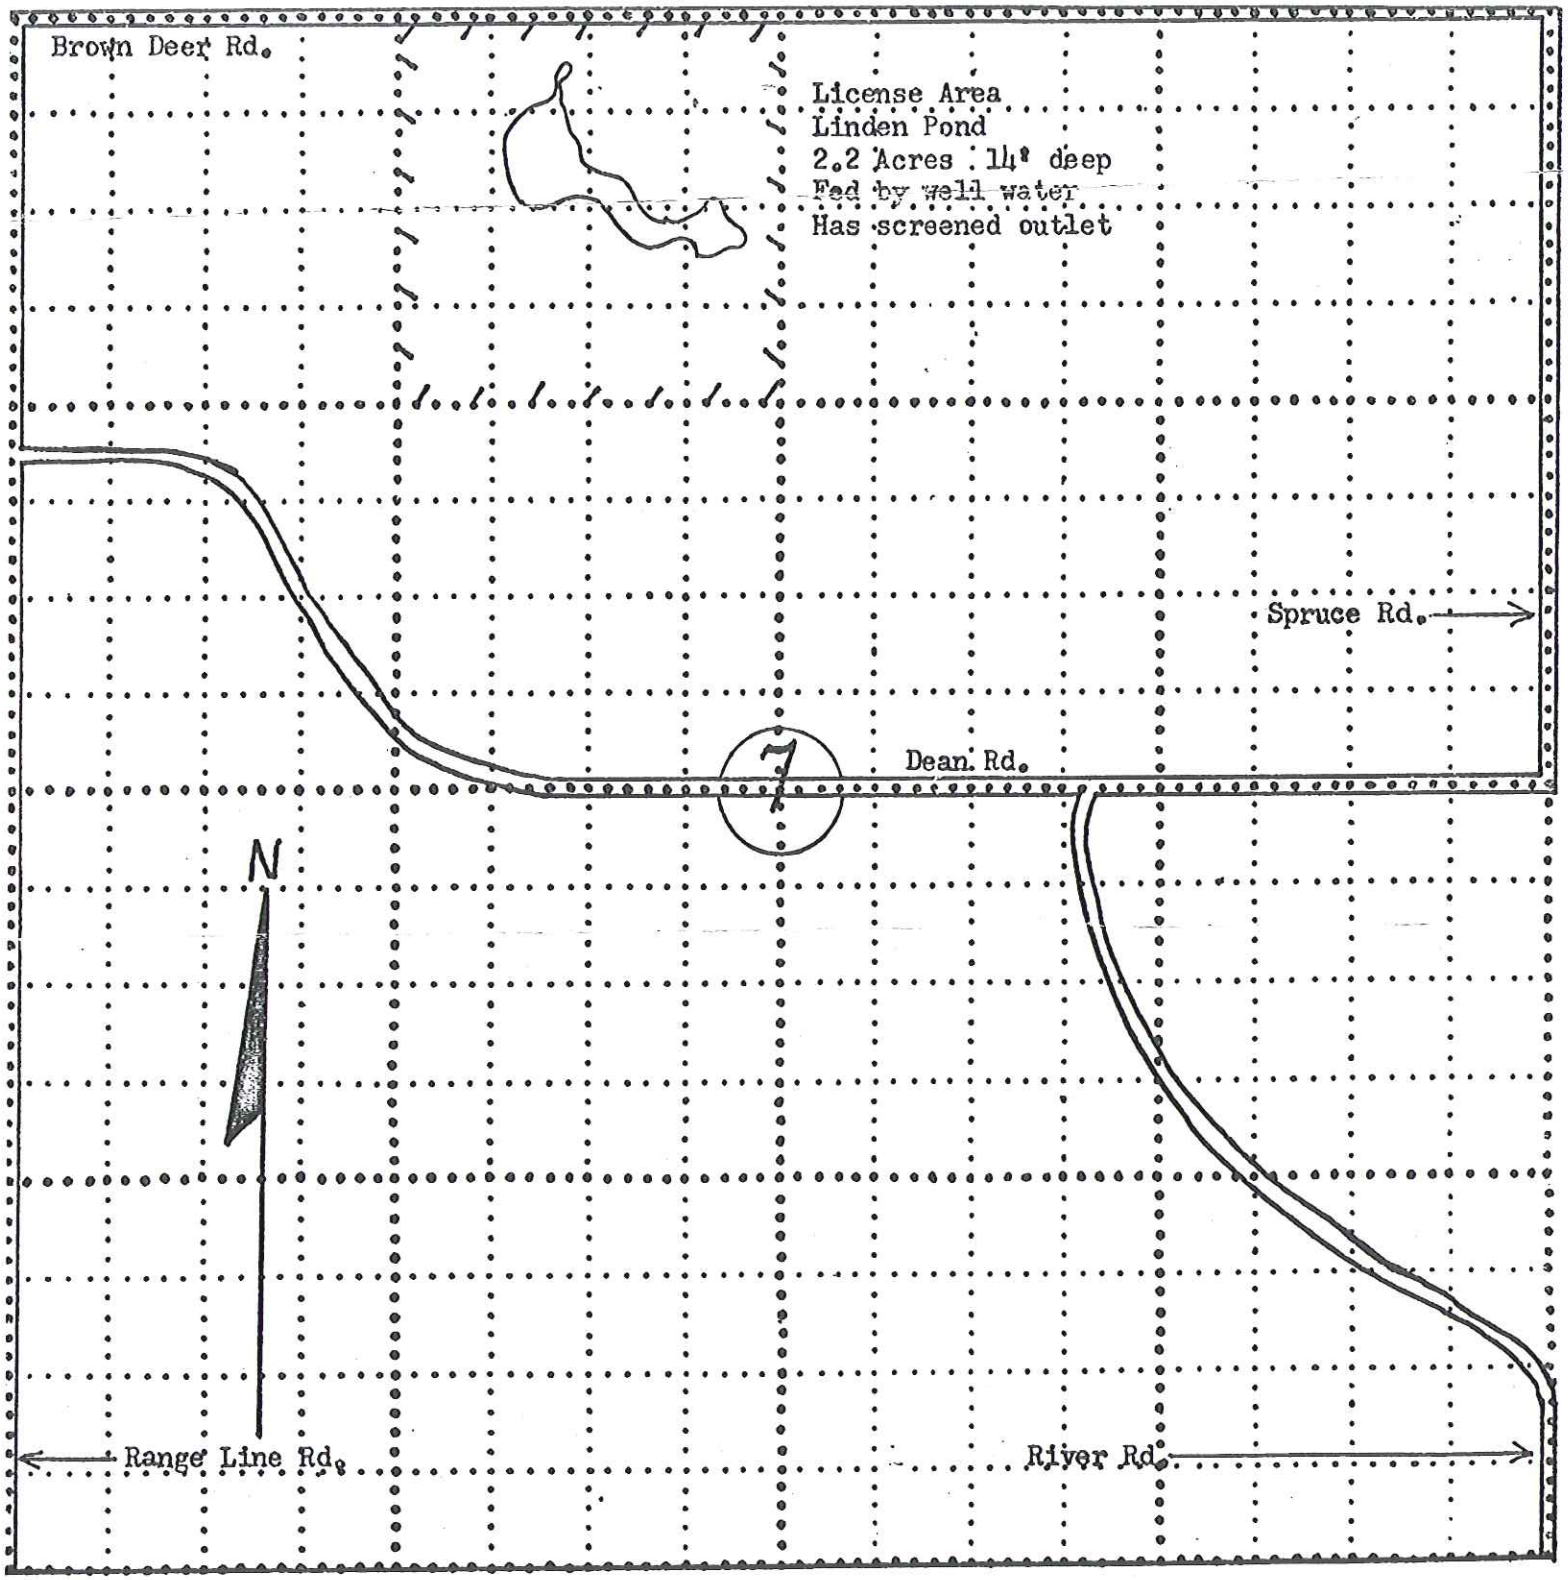

REV. 10-67

BEARING TREE-BT. MARKED TREE-MT. SQUARED TREE-ST. WOOD POST-WP. IRON POST-IP. CONCRETE POST-CP

APPLICATION FOR PRIVATE FISH HATCHERY

FORM 9400-25

STATE OF WISCONSIN
DEPARTMENT OF NATURAL RESOURCES
Box 450
Madison, Wisconsin 53701

License Expires December 31

Mrs. Harry Lynde Bradley, Pres.
Bradley Family Foundation, Inc.
Sculpture Gardens
2145 W. Brown Deer Road
Milwaukee, Wisconsin 53217

LICENSE CLASS
☐ A - $50 ☐ B - $25 ☒ C - $5 ☐ D - $5

APPLICATION FOR

☐ NEW

☐ SUPPLEMENTAL TO LIC. NO. _____

NAME OF FIRM	ADDRESS

DID YOU HAVE A PRIVATE FISH HATCHERY LAST YEAR? ☐ YES ☒ NO	IF YES, INDICATE CLASS .....AND.....	IF YES, IS A COMPLETED VERIFIED REPORT ATTACHED? ☐ YES ☐ NO

SOURCE OF WATER:

☐ SPRINGS ☐ WELL ☐ STREAMS ☐ SURFACE RUNOFF ☐ CITY WATER ☐ OTHER - Explain .....

Pursuant to the provisions of Section 29.52 of the Wisconsin Statutes, as the owner _____ or lessee _____ of certain lands, hereinafter described, I herewith apply for a Class _____ Private Fish Hatchery License:

SPECIES OF FISH TO BE PROPAGATED

Fish:	Eggs:

Such private fish hatchery is to be located on the following described lands, all within the boundaries of the State of Wisconsin: (Give exact legal description of area to be licensed.)

Milwaukee County - Township 8 North, Range 22E (E. or W.). Section 7, ____ ¼ ____ ¼.
N ½ of the E ½ of the NW ¼

(Attach description, diagram or sketch of pond, raceways, wells, flumes, dams, buildings and other improvements in connection with proposed hatchery. (For new applications only)

SIGNATURE OF APPLICANT	DATE
Mrs. Harry Lynde Bradley, Pres.	May 1, 1975

Please be sure all items are answered and the applicant's signature affixed before submitting.
The correct class fee should be attached, check or money order preferred to cash.

Bradley Family Foundation, Inc.

(OVER)

PRIVATE FISH HATCHERY LICENSE
Form 9400-26C

STATE OF WISCONSIN
DEPARTMENT OF NATURAL RESOURCES
Box 450
Madison, Wisconsin 53701

Margaret B. Bradley
2145 W. Brown Deer Road
Milwaukee, Wisconsin 52217

Date	July 12, 1971
License Class	C
License No.	3149
License Fee	$5.00
License Expires On	December 31, 1971

is hereby licensed, subject to Section 29.52 (4) (c), Wisconsin Statutes, to conduct and operate a Class "C" private fish hatchery to:

1. Have live eggs or fish lawfully in his possession by purchase or otherwise; and
2. Maintain and operate an artificial fish hatching facility and hatch eggs but not for sale or trade except that bait minnows so produced may be sold or traded; or
3. Stock, maintain or hold such live fish eggs or fish for natural propagation, display, or fishing by himself or others, but does not sell or trade such fish eggs or fish and does not permit public fee fishing for such fish; or
4. Stock, maintain or hold live fish for display or for sale and consumption on the premises; or
5. Sell game fish lawfully in his possession, by purchase or otherwise to Class "A" licensees.

Species of fish to be propagated:

Fish Largemouth Bass; Bluegill
Eggs

On the following described property:

1 artificial 2.2 acre pond, the water source of which is a well

Township 8 North, Range 22 East, Milwaukee County
Section 7 - $NE\frac{1}{4}$ $NW\frac{1}{4}$

State of Wisconsin
Department of Natural Resources
For Secretary

By C. R. Smith
Administrator

Issued By
Dorothy Paulsen

Wisconsin Department of Agriculture, Trade and Consumer Protection

2811 Agriculture Drive, PO Box 8911, Madison, WI 53708-8911

Effective Date: April 01, 2013
Expires: March 31, 2014
Statute: 95.60

Registration Number: 112551-AQ

Fish Farm Registration

Legal Name:
Bradley Family Foundation, Inc.
Business Location:
2145 W Brown Deer Rd Milwaukee WI 53217

Doing Business As:
Lynden Sculpture Garden

Livestock Premises Code(s): 00766GF

Type 1 Fish Farm

This is your license/permit/certification/registration document. Post or carry as required by law. Non-transferrable - subject to revocation or suspension as provided by law.
DMS-BIT-06B (03/19/10)

Remove this card and carry as identification.

bits-16.qxd (rev.03/12)

BRADLEY FAMILY FOUNDATION, INC.
2145 BROWN DEER RD
MILWAUKEE WI 53217

DATCP Contact : (608) 224-4887

Wisconsin Department of Agriculture, Trade and Consumer Protection

Fish Farm Registration
Type 1 Fish Farm
Bradley Family Foundation, Inc.
Registration Number: **112551-AQ**
Expiration Date: **March 31, 2014**
2145 W Brown Deer Rd Milwaukee WI 53217

1991 Plate Scale 1" = 200ft.

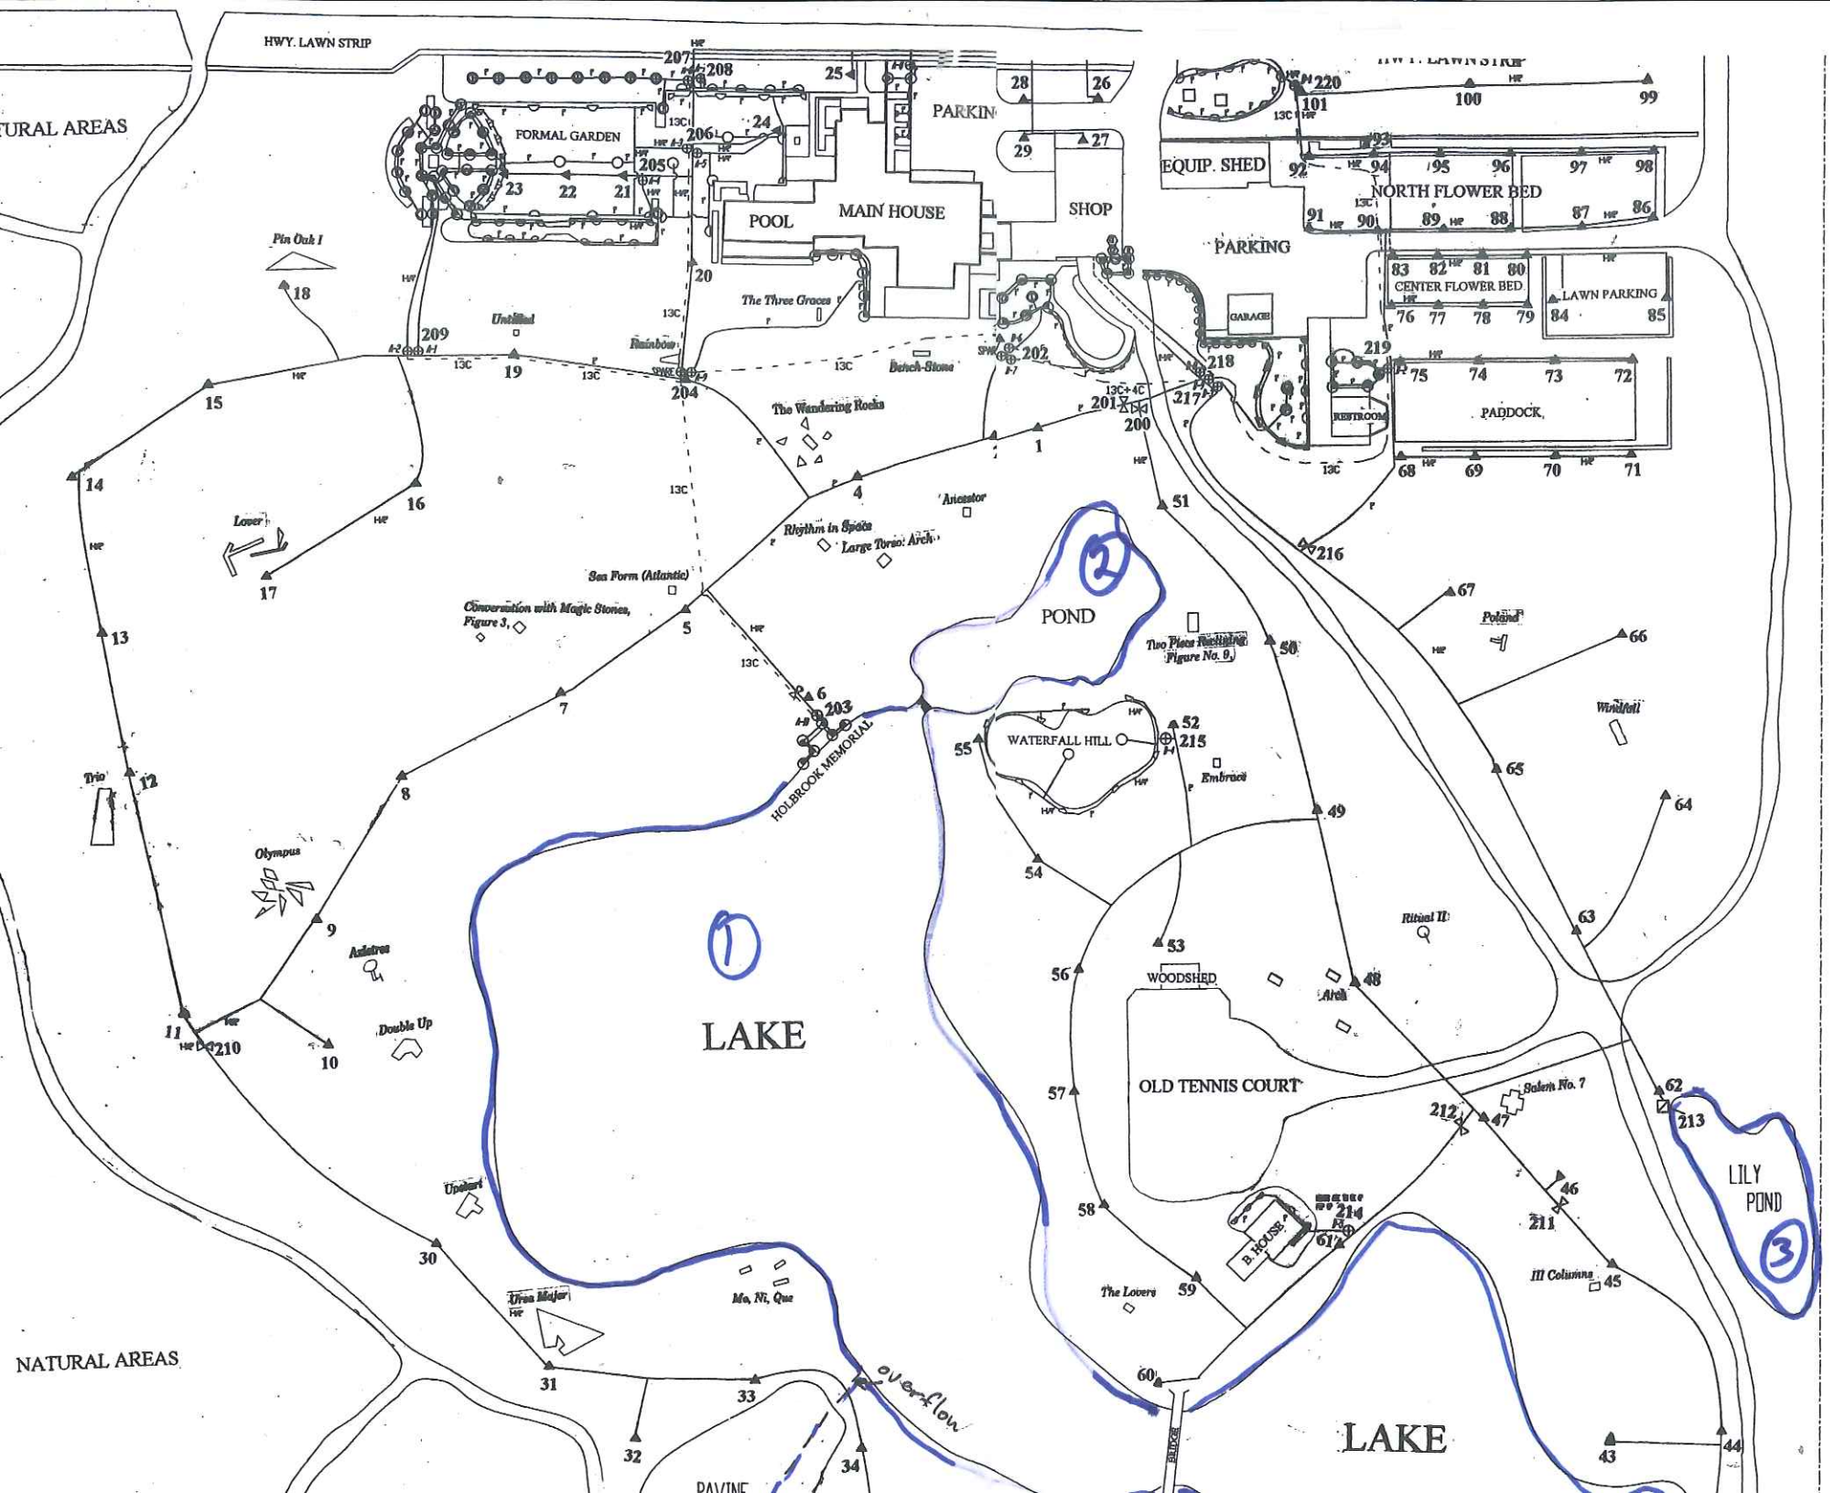

LEGEND

	TORO SERIES VISION II 12 STA CONTROLLER WITH RAIN SWITCH			
	AUTOMATIC RAIN SENSOR			
	TORO SERIES 252 ELECTRIC VALVE			
	TORO SERIES 474-01 QUICK COUPLING VALVE 1"			
	TORO SERIES 570H SPRINKLER F 60	63		48'
	TORO SERIES 570H SPRINKLER PC 45	37		48'
	TORO SERIES 570H SPRINKLER PC 30	30		48'
	TORO SERIES 570H SPRINKLER PC 15	15		48'
	TORO SERIES 300 DYNA SPRINKLER 360 DEG.	63		36'
	TORO SERIES 300 DYNA SPRINKLER 270 DEG.	32		36'
	TORO SERIES 300 DYNA SPRINKLER 180 DEG.	30		36'
	TORO SERIES 300 DYNA SPRINKLER 90 DEG.	15		36'
	TORO SERIES 570 SPRAY HEAD 360 DEG.	46		15'
	TORO SERIES 570 SPRAY HEAD 270 DEG.	34		15'
	TORO SERIES 570 SPRAY HEAD 180 DEG.	21		15'
	TORO SERIES 570 SPRAY HEAD 120 DEG.	15		15'
	TORO SERIES 570 SPRAY HEAD 90 DEG.	12		15'
	TORO SERIES 570 SPRAY HEAD 360 DEG. LOW GAL.	23		12'
	TORO SERIES 570 SPRAY HEAD 270 DEG. LOW GAL.	18		12'
	TORO SERIES 570 SPRAY HEAD 240 DEG. LOW GAL.	18		12'
	TORO SERIES 570 SPRAY HEAD 180 DEG. LOW GAL.	16		12'
	TORO SERIES 570 SPRAY HEAD 120 DEG. LOW GAL.	18		12'
	TORO SERIES 570 SPRAY HEAD 90 DEG. LOW GAL.	6		12'
	TORO SERIES 570 SPRAY HEAD 180 DEG.	18		18'
	TORO SERIES 570 SPRAY HEAD 90 DEG.	18		18'
	TORO SERIES 570 SPRAY HEAD 360 DEG. FLAT SPRAY	.7		7'
	TORO SERIES 570 SPRAY HEAD 360 DEG. FLAT SPRAY	5		9'
	TORO SERIES 570 SPRAY HEAD 270 DEG. FLAT SPRAY	4		9'
	TORO SERIES 570 SPRAY HEAD 240 DEG. FLAT SPRAY	3.5		9'
	TORO SERIES 570 SPRAY HEAD 180 DEG. FLAT SPRAY	3		9'
	TORO SERIES 570 SPRAY HEAD 120 DEG. FLAT SPRAY	2		9'
	TORO SERIES 570 SPRAY HEAD 90 DEG. FLAT SPRAY	1.5		9'
	TORO SERIES 570 SPRAY HEAD END STRIP	12 (4' X 30')		
	1-1/2" PRESSURE RELIEF VALVE			
	ISOLATION VALVE			
	SCH 26 PVC MAIN LINE 2"			
	1/2-100 POLY LATERAL PIPE 12" UNLESS OTHERWISE NOTED			
	PVC SLEEVE (2 PIPE SIZES LARGER THAN WATER LINE)			

QTY	KEY	SYMBOL	DESCRIPTION	MFR	MODEL NO.	NOZZLE

VALVE LEGEND

VALVE NO.	VALVE SIZE	GPM	PRECIP.
A-1	1"	152	1.6
A-2	1"	209	1.7
A-3	1"	285	1.7
A-4	1-1/2"	326	0.55
A-5	1-1/2"	249	1.7
A-6	1-1/2"	365	0.55
A-7	1"	218	1.7
A-8	3/4"	44	1.6
A-9	1"	76	1.6
A-10	3/4"	36	1.6
A-11	SPARE		
A-12	SPARE		
B-1	1"	281	1.7
B-2	3/4"	48	1.7
B-3	1"	237	1.7
B-4	1-1/2"	488	0.8
B-5	3/4"	45	1.7
B-6	1"	81	1.4
B-7	1"	39	1.4
B-8	1"	98	1.7
B-9	1"	44	1.6
B-10			
B-11			
B-12			

AS BUILT PLAN

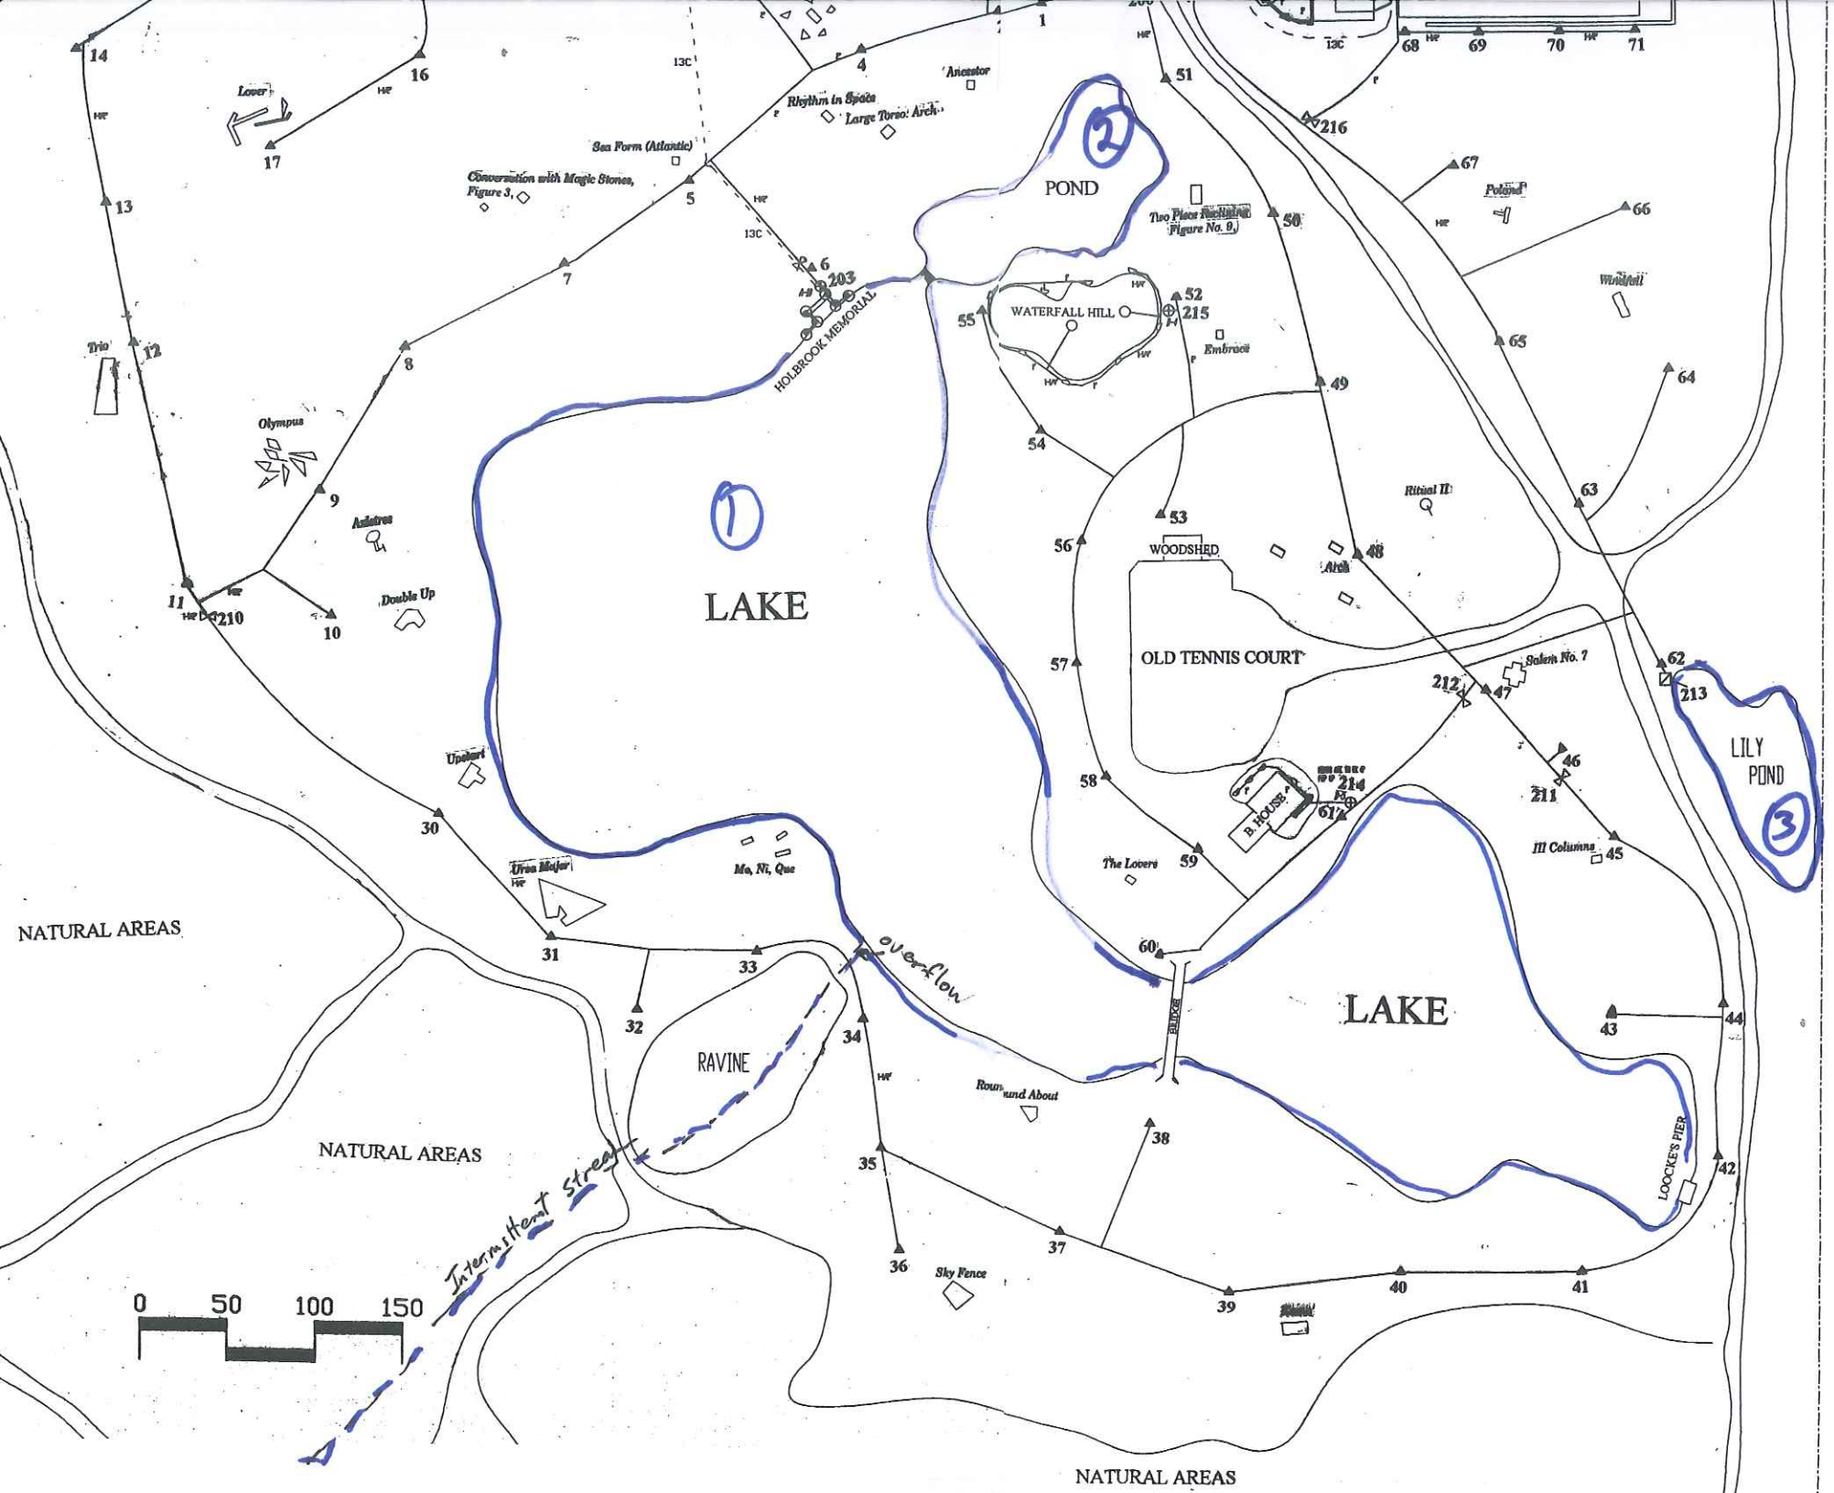

		TORO SERIES 570 SPRAY HEAD 120 DEG. LOW GAL.	LB		12'
		TORO SERIES 570 SPRAY HEAD 90 DEG. LOW GAL.	6		12'
		TORO SERIES 570 SPRAY HEAD 180 DEG.	LB		18'
		TORO SERIES 570 SPRAY HEAD 90 DEG.	LB		18'
		TORO SERIES 570 SPRAY HEAD 360 DEG. FLAT SPRAY	7		7'
		TORO SERIES 570 SPRAY HEAD 360 DEG. FLAT SPRAY	5		5'
		TORO SERIES 570 SPRAY HEAD 270 DEG. FLAT SPRAY	4		5'
		TORO SERIES 570 SPRAY HEAD 240 DEG. FLAT SPRAY	35		5'
		TORO SERIES 570 SPRAY HEAD 180 DEG. FLAT SPRAY	13		5'
		TORO SERIES 570 SPRAY HEAD 120 DEG. FLAT SPRAY	2		5'
		TORO SERIES 570 SPRAY HEAD 90 DEG. FLAT SPRAY	35		5'
		TORO SERIES 570 SPRAY HEAD END STOP	12 (4' RISE)		
		1-1/2" PRESSURE RELIEF VALVE			
		ISOLATION VALVE			
		SIZES PVC MAIN LINE 2"			
		160-200 POLY LATERAL PIPE 0" UNLESS OTHERWISE NOTED			
		PVC SLEEVE (2 PIPE SIZES LARGER THAN WATER LINE)			

VALVE LEGEND

VALVE NO.	VALVE SIZE	GPM	PRESSURE
A-1	1"	152	16
A-2	1"	230	17
A-3	1"	285	17
A-4	1-1/2"	326	656
A-5	1-1/2"	240	17
A-6	1-1/2"	365	656
A-7	1"	210	17
A-8	3/4"	44	16
A-9	1"	76	16
A-10	3/4"	36	16
A-11	SPARE		
A-12	SPARE		
B-1	1"	211	17
B-2	3/4"	48	17
B-3	1"	237	17
B-4	1-1/2"	489	88
B-5	3/4"	45	17
B-6	1"	81	14
B-7	1"	39	14
B-8	1"	98	17
B-9	1"	44	16
B-10			
B-11			
B-12			

AS BUILT PLAN

INSTALLED AND REVISED BY:

ACME SYSTEMS, INC.

REVISED 07-02-96	AS BUILT DRAWN BY: DEBBIE GASPARAC PLAN# C-9617

T. J. EMMERICH ASSOCIATES, INC.

BRADLEY FAMILY ESTATE
SCULPTURE GARDEN
IRRIGATION SYSTEM

SIZE E	REVISED 12-21-95	DWG NO. 19930220	REV
SCALE 1"=50'	DATE: DECEMBER 6, 1993	SHEET 1 OF 1	

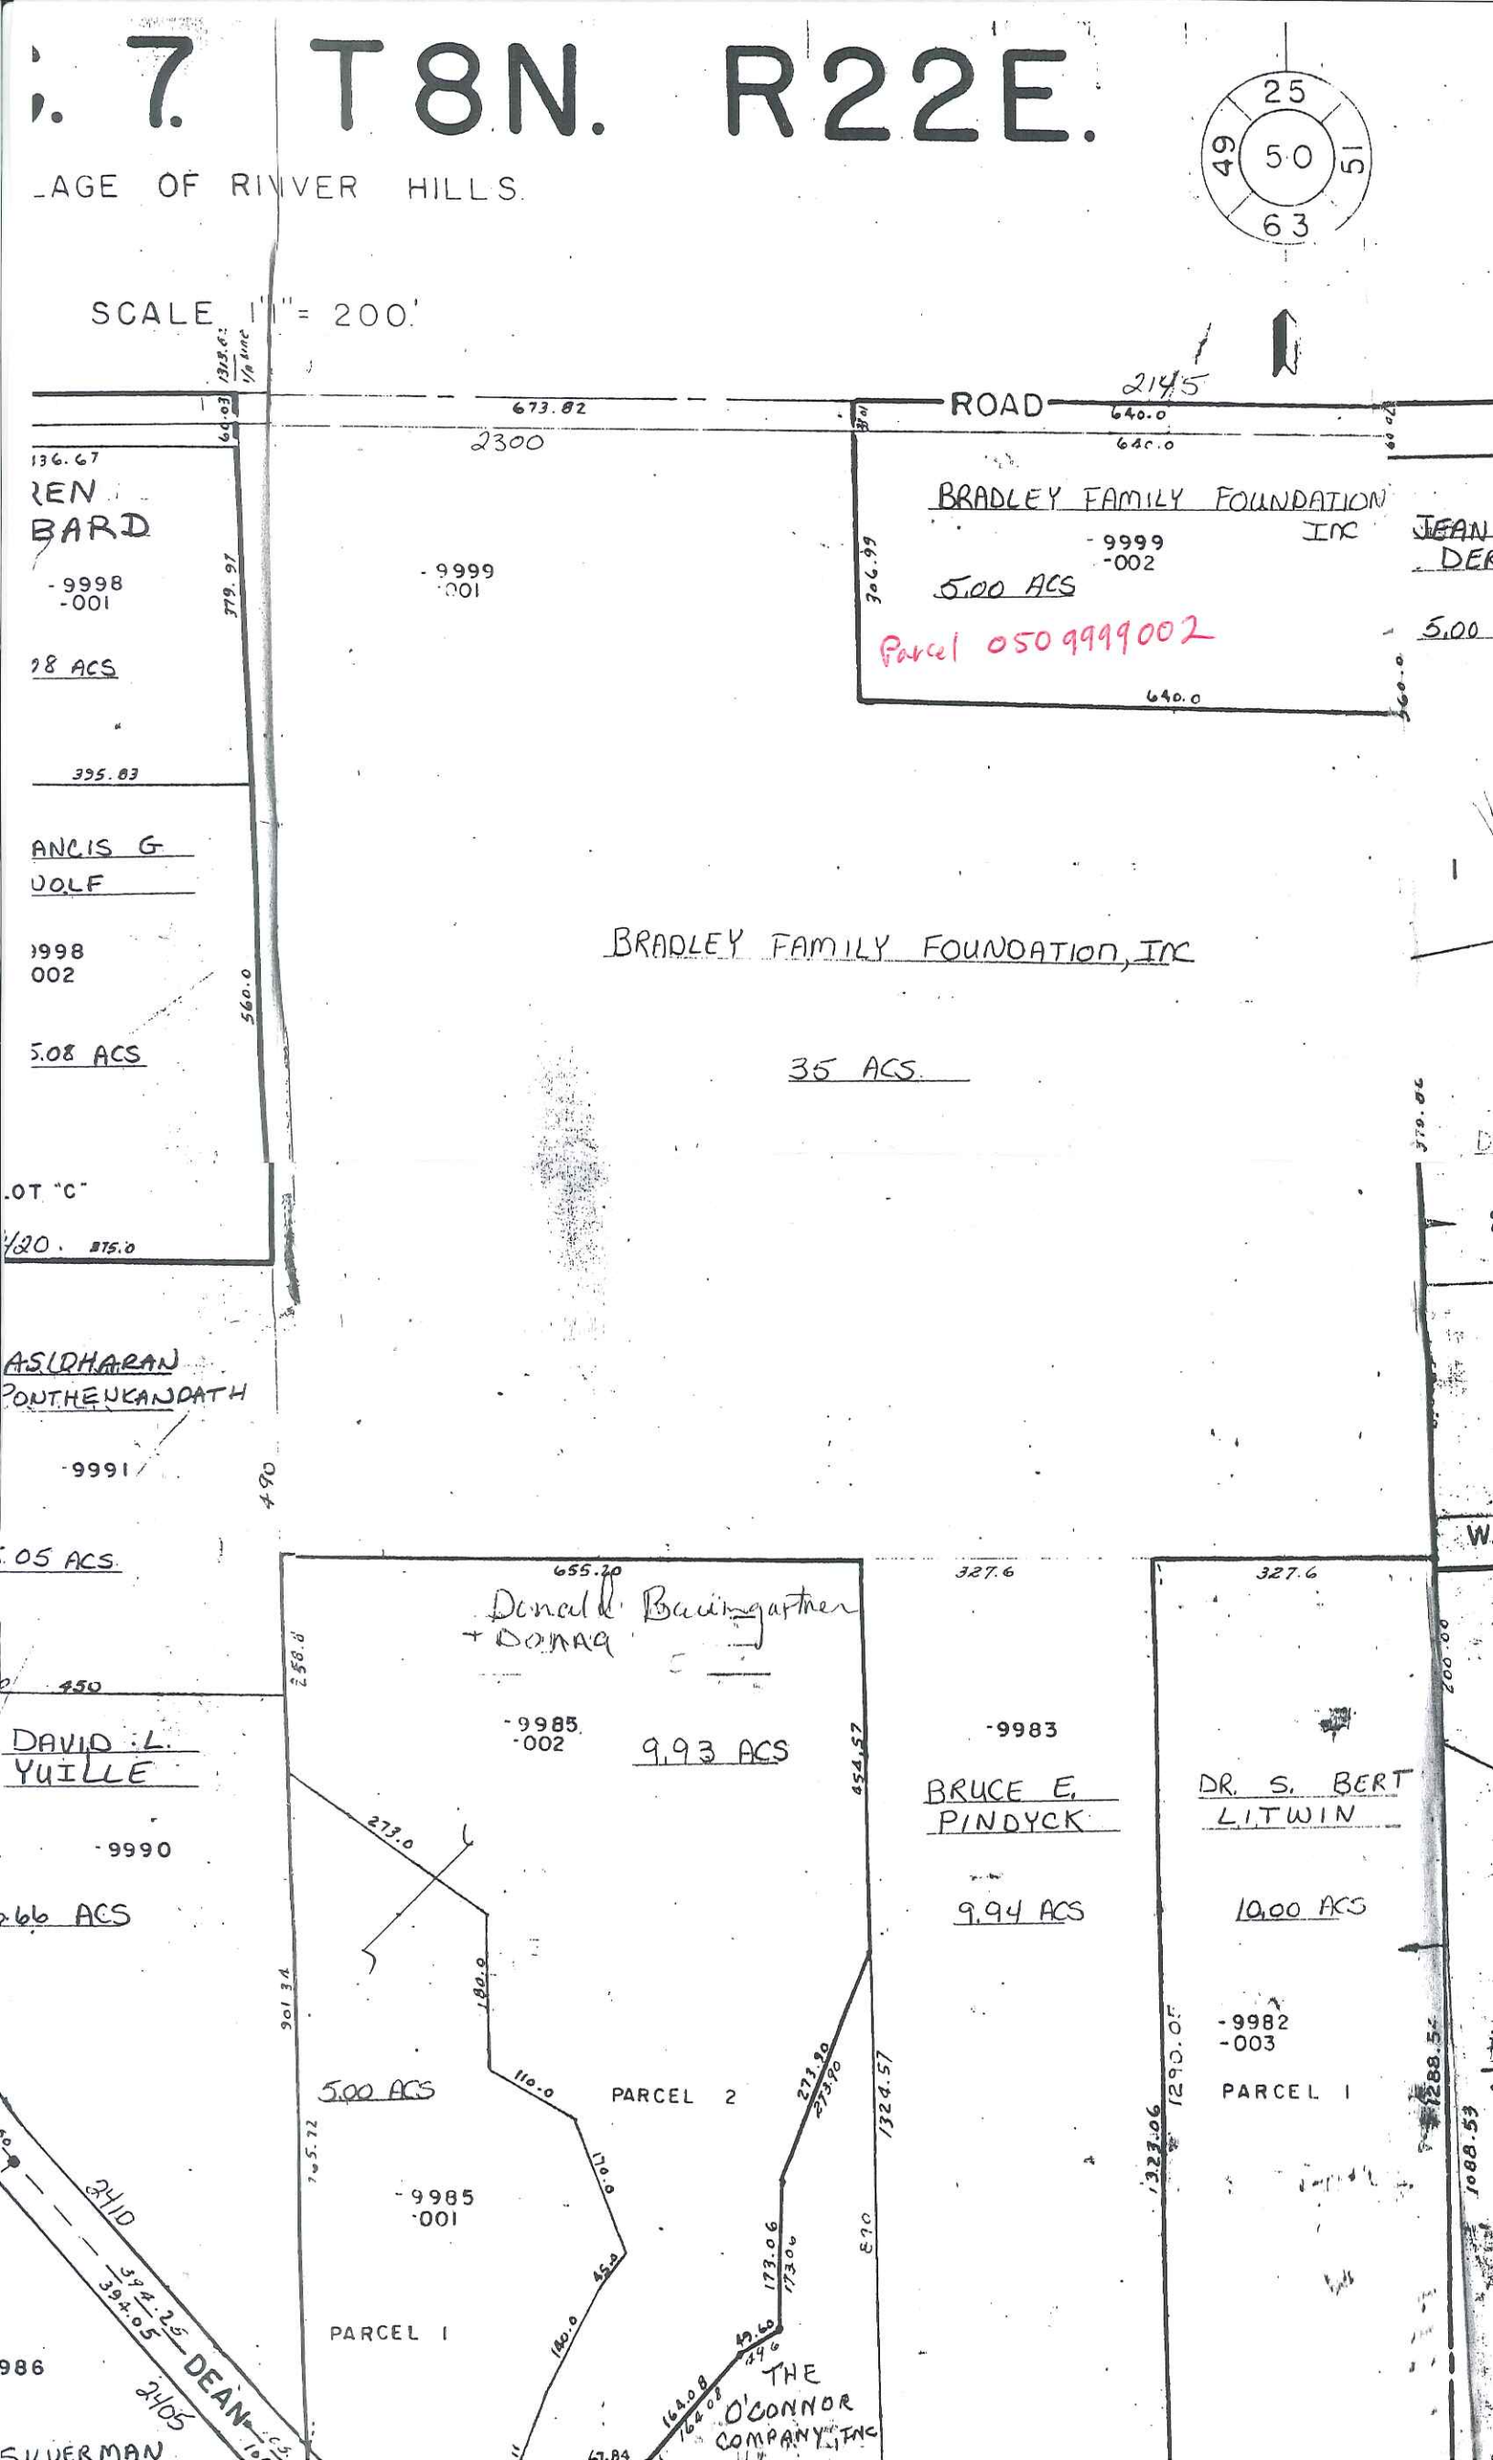
7. T8N. R22E.
AGE OF RIVER HILLS.
SCALE 1" = 200'
25
49
50
51
63
ROAD
2145
2300
673.82
640.0
BRADLEY FAMILY FOUNDATION INC
-9999
-002
5.00 ACS
Parcel 050 9999002
BRADLEY FAMILY FOUNDATION, INC
35 ACS.
-9998
-001
-9999
-001
-9991
-9990
-9985
-002
9.93 ACS
Donald L. Baumgartner + DONNA
-9985
-001
5.00 ACS
PARCEL 2
PARCEL 1
-9983
BRUCE E. PINDYCK
9.94 ACS
DR. S. BERT LITWIN
10.00 ACS
-9982
-003
PARCEL 1
DAVID L. YUILLE
THE O'CONNOR COMPANY, INC
DEAN
655.20
327.6
327.6
454.57
1324.57
1323.06
1290.05
1288.52
1088.53
273.0
180.0
110.0
170.0
140.0
173.06
173.00
164.08
164.08
49.60
49.6
47.84
2410
2405
394.25
394.05

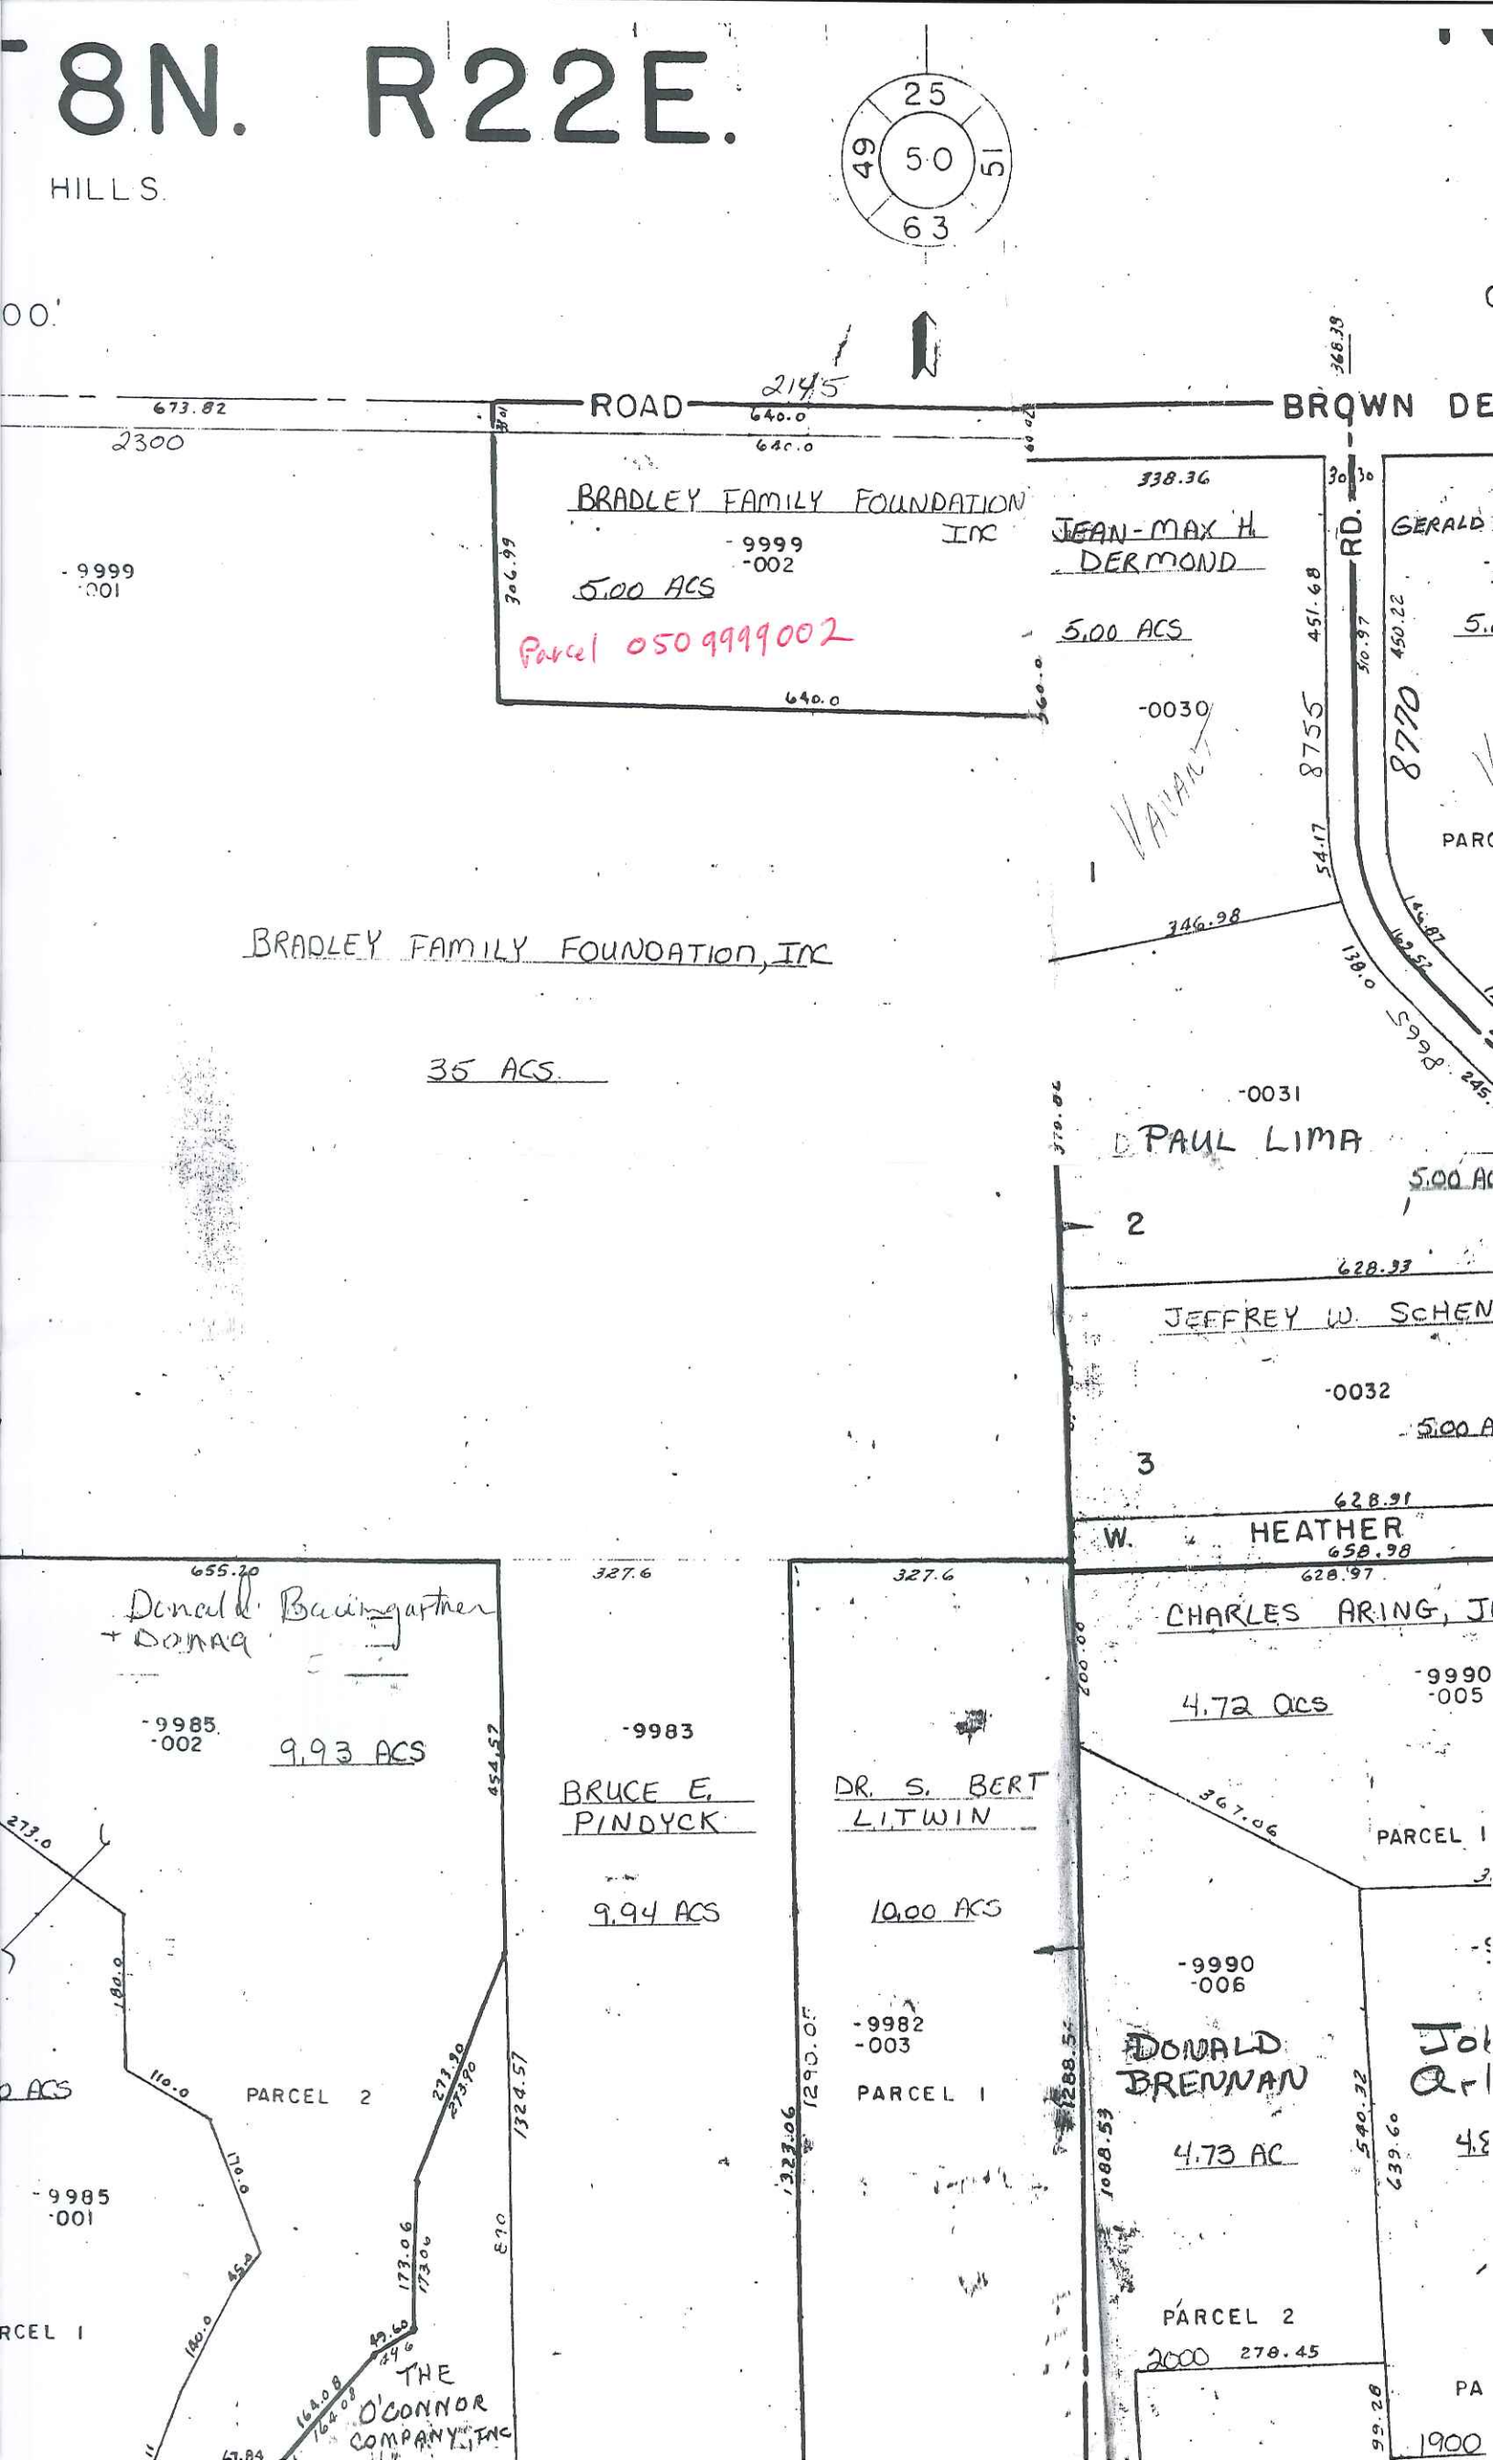
8N. R22E.
HILLS
25
49
50
51
63
ROAD
2145
BROWN DE
673.82
2300
640.0
640.0
BRADLEY FAMILY FOUNDATION INC
-9999
-002
5.00 ACS
Parcel 0509999002
306.99
640.0
-9999
-001
338.36
JEAN-MAX H. DERMOND
5.00 ACS
-0030
VACANT
RD.
8755
8770
GERALD
451.68
54.17
346.98
BRADLEY FAMILY FOUNDATION, INC
35 ACS.
-0031
PAUL LIMA
5.00 AC
2
628.33
JEFFREY W. SCHEN
-0032
5.00 A
3
628.91
W. HEATHER
658.98
628.97
655.20
Donald L. Baumgartner + Donna
-9985
-002
9.93 ACS
327.6
-9983
BRUCE E. PINDYCK
9.94 ACS
327.6
DR. S. BERT LITWIN
10.00 ACS
CHARLES ARING, JR
-9990
-005
4.72 ACS
200.00
367.06
PARCEL 1
-9990
-006
DONALD BRENNAN
4.73 AC
-9982
-003
PARCEL 1
1290.05
1323.06
1288.52
1088.53
540.32
439.60
PARCEL 2
2000
278.45
273.0
180.0
110.0
PARCEL 2
-9985
-001
170.0
46.0
140.0
173.06
173.06
49.50
49.6
164.08
164.08
THE O'CONNOR COMPANY, INC
454.52
273.90
273.90
1324.57
670
99.28
1900